



<b>Project:</b>	2023-RFT-058 Lift Station 1 & Lower Iqaluit PT.A2 to LS1 Project		
<b>Addendum No.</b>	4	<b>No. of Pages:</b>	16
<b>Date:</b>	August 14, 2023	<b>Doc. No:</b>	P7201-810372863-118(1.0)

The following change(s) in the Request for Quotation Documents are effective immediately.  
This Addendum forms part of the Contract Documents.

#### CLARIFICATIONS

- Q1.** Would you be able to provide specifications of material and thickness of the weatherproof backer on the aluminum signs, as seen in M-602?
- A1:** For the signs that are shown on M602 provide a 3.0mm thick aluminum alloy 5052-H32. For the weatherproof backer provide a ¼" crezon plywood.
- Q2.** Would you be able to provide locations of construction joints?
- A2:** The locations of construction joints are to be determined by the contractor based on pour breaks.
- Q3.** Would you be able to provide more detail, such as location, on waterstop detail 3S-403?
- A3:** Waterstop shall be installed at all locations of construction joints.
- Q4.** Drawing A-301 shows guardrail and refers to structural drawings but there is no detail on the guardrail. Please provide detail on guardrail.
- A4:** Refer to drawings provided with this addendum.
- Q5.** Please provide dimensions and detail on the baffle wall including bent plate details.
- A5:** Refer to drawings provided with this addendum.
- Q6.** On S-002 it is indicated that we should refer to plans for analysis of snowdrift and wind uplift but there are no diagrams for snowdrift or wind uplift. Please provide the diagrams.
- A6:** There is no snow drift. For wind uplift, refer to drawings provided with this addendum.
- Q7.** Can you provided the anticipated peak flow rates from existing sewers entering LS1?
- A7:**
- MH 437 to LS#1

- Peak: 5.3 L/s
  - Average: 1.5 L/s
- MH 1 to LS#1
  - Peak: 38.0 L/s
  - Average: 11.2 L/s

**Q8.** The structural plan indicates 18" TJI joists and rim board, the joist manufacturer recommends changing the details at bearing from continuous rim board to TJI blocking panels. Would this be acceptable?

**A8:** This is acceptable.

**Q9.** As this is a TJI roof, the joist manufacturer would recommend adding blocking panels to the design. Would this be acceptable?

**A9:** This is acceptable.

**Q10.** The specs indicate culverts, but they are not identified on the drawings. Please indicate where the culverts are on the drawings.

**A10:** There are no culverts noted in the drawings.

**Q11.** With the heavy portion of design delegation requirements as part of this project, an extension of time is requested to aid in sourcing licensed engineers who can join the team and review the documents to provide preliminary guidance for pricing and estimation purposes. A two (2) week extension is requested and would be appreciated. We do not believe this would interfere with the project delivery dates either.

**A11:** This is acceptable. New established dates are as follows:

- Inquiry deadline: August 21 @ 3 PM EST
- Addendum deadline: August 24 @ 3 PM EST
- Submission deadline: August 30 @ 3 PM EST

**Q12.** In 2021 the City did a project call the temporary lift station bypass project and the City purchased an equalization tank (frack Tank) and electric drive pumps. Will it be possible to use these items for the present project? if yes can we get the specs for these items?  
Also, can you confirm that the tie-in to existing force main planned to be done in the project in 2021 was done as per design and usable for this RFT?

**A12:** The frac tank is available. Note the following:

- Frac tank only is being supplied, no inlet or outlet piping.
- Contractor is responsible for picking up the tank from a City-specified location.
- Contractor is responsible for returning the tank at a City-specified location.

- Contractor is responsible for any repairs or replacements if any damage is incurred on the tank.
- Bypass design drawings are being provided to show the intended design of the tank and forcemain tie-in. The City is not responsible and will not accommodate any cost changes for any deviations in actual conditions at the time of tank pickup.

**Q13.** Can we have the estimated flow coming from MH2 and also the line coming from AV437?

**A13:** Refer to A7. There is no contribution flow between MH 2 and MH 1, so it is the same flow through MH 2 and MH 1.

**Q14.** Referring to addendum 2, please provide the section mentioned in addendum 2 (07 15 50 & 26 29 33)

**A14:** Variable Frequency Drives should be section 26 29 23, not 26 29 33.  
For section 07 15 50, a later addendum will be provided.

**Q15.** Referring to addendum 2, we can't put the specified waterproofing membrane under the slab as shown on drawing 7/A-402, we can consider it on wall foundation, please advise on which other we could combine for under the slab.

**A15.** Under slab to have sheet vapour barrier as per spec section 07 26 00.

**Q16.** Referring to specification section 03 30 00 2.10 B, the hardeners are specified to use where indicated in "the room finish schedule". We didn't find this schedule, could you provide it?

**A16.** Hardener to be applied to all top surface of mainfloor slab.

**Q17.** Referring to specification section 03 30 00 2.12, is sandblasting necessary for this tender?

**A17.** Sandblasting may be required to prepare surface to receive protective coating by coating manufacturer.

**Q18.** The civil drawings label the piles as concrete piles. Are concrete piles required or can typical adfreeze piles per the details provided be acceptable?

**A18.** Refer to structural drawings for pile design.

#### DRAWING REVISIONS

1. S-103 Revision F, Structural Lift Station No. 1, Main Floor Framing Plan
2. S-104 Revision F, Structural Lift Station No. 1, Roof Framing Plan

3. S-301 Revision F, Structural Lift Station No. 1, Sections and Details Sheet 1 of 3
4. S-405 Revision D, Structural Lift Station No. 1, Typical details Sheet 5 of 5

#### ATTACHMENTS

1. Drawings:
  - S-103 dated 8/11/2023
  - S-104 dated 8/11/2023
  - S-301 dated 8/11/2023
  - S-405 dated 8/11/2023
2. City of Iqaluit Lift Station No. 1, Temporary Bypass, As-built Drawings – January 2023

1

2

3

4


5

D

C

B

A

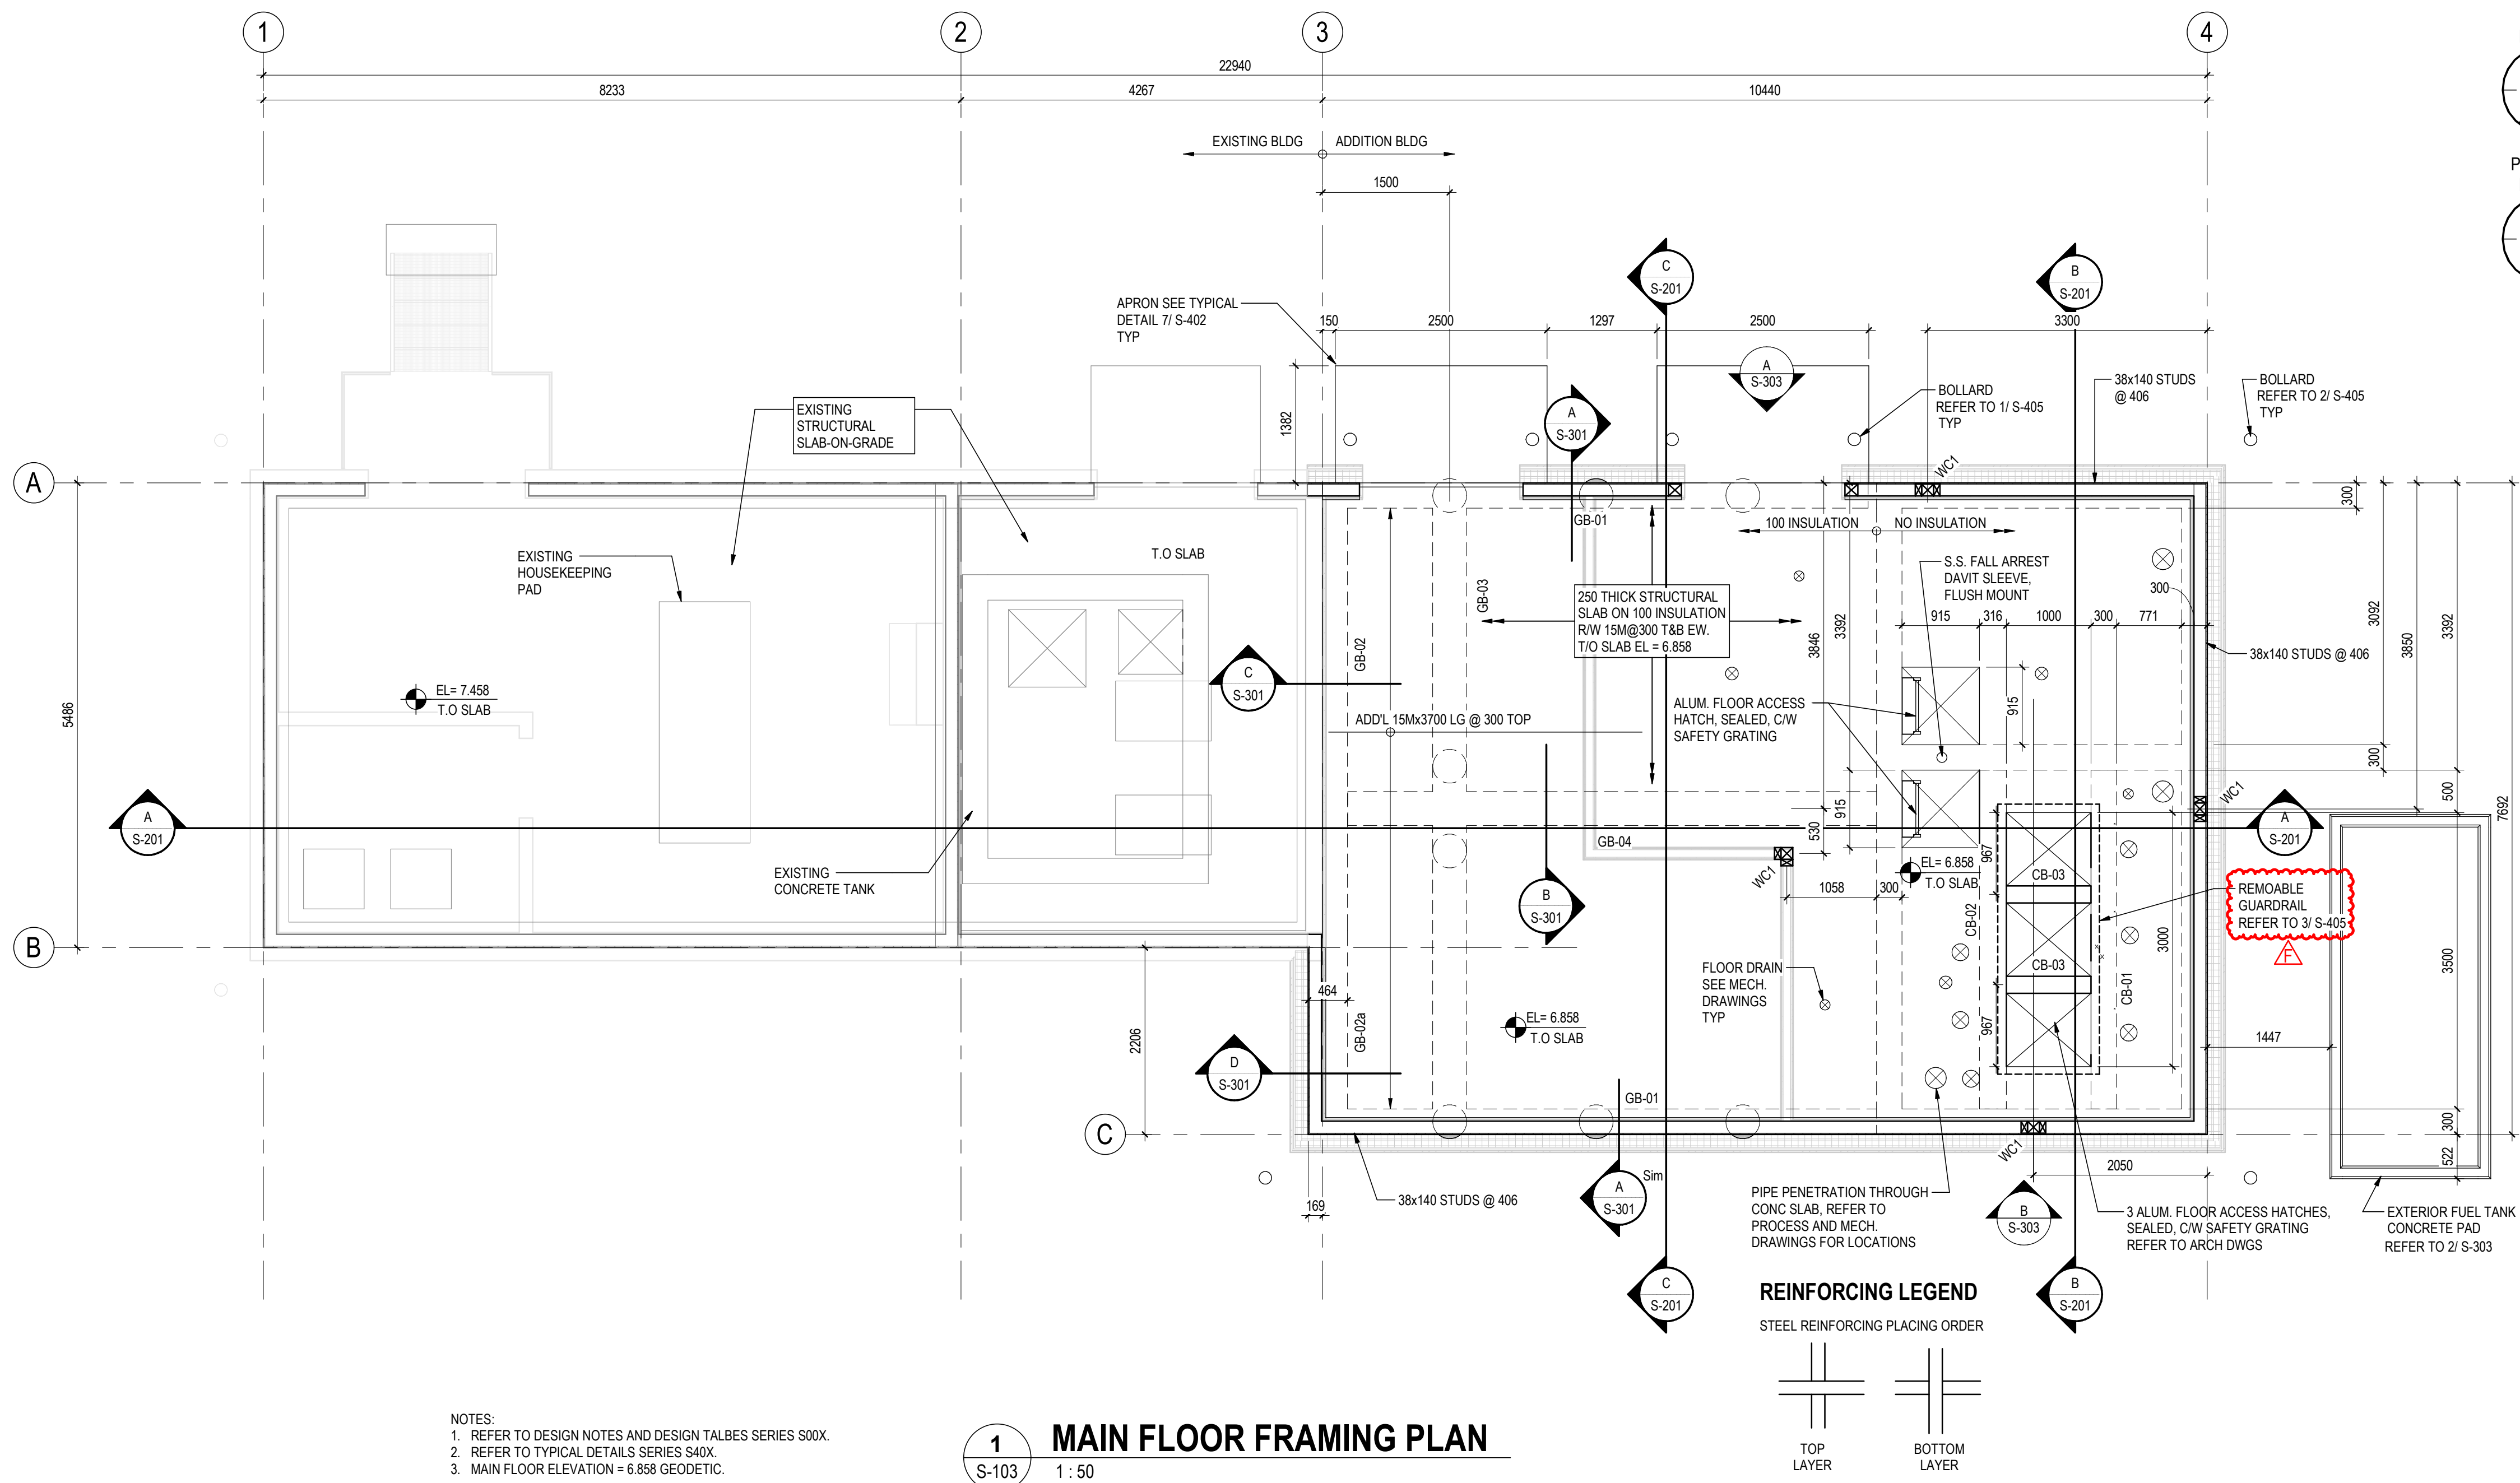

# 1 MAIN FLOOR FRAMING PLAN

1:50

## CONCRETE BEAM SCHEDULE

MARK	WIDTH	DEPTH	TOP REINF.	BOT REINF.	STIRRUPS	COMMENTS
CB-01	300	500	4-20M	2-20M	10M@200	
CB-02	316	500	4-20M	2-20M	10M@200	
CB-03	200	300	2-20M	2-20M	10M@200	TOP OF BEAM TO BE BOTTOM OF HATCH DOOR FRAMING

### NOTES:

- HOOK THE TOP AND BOTTOM REINF INTO GRADE BEAM / CONCRETE WALL.
- ALL STIRRUPS ARE CLOSED TIES.

## GRADE BEAM SCHEDULE

MARK	WIDTH	DEPTH	TOP REINF.	BOT REINF.	HORIZONTAL EF	STIRRUPS	COMMENTS
GB-01	300	700	4-25M	3-20M	2-15M E.F.	10M@300	10M@100 STIRRUPS AT CANTILEVER
GB-02	300	700	2-20M	2-20M	2-15M E.F.	10M@300	
GB-02a	464	700					REFER TO SECTION 6/S301
GB-03	400	700	4-25M	4-20M	2-15M E.F.	10M (4 LEGS) @ 300, 10M (4 LEGS) @ 100 MID-SPAN	
GB-04	400	700	4-25M TUL + 2-25M TLL	4-20M BOT	2-15M E.F.	10M@300	10M (4 LEGS) @100 STIRRUPS AT CANTILEVER

## WOOD COLUMN SCHEDULE

MARK	SIZE	COMMENTS
WC1	140x140	

### NOTES:

- SEE DETAIL A/S303 AND 1/S303.



Stantec Consulting Ltd.  
1088C Noble House  
PO Box 1779  
Iqaluit, NU X0A 0H0  
Tel: (867) 979-0555 • www.stantec.com

### Copyright Reserved

The Copyrights to all designs and drawings are the property of Stantec. Reproduction or use for any purpose other than that authorized by Stantec is forbidden. The Contractor shall verify and be responsible for all dimensions. DO NOT scale the drawing - any errors or omissions shall be reported to Stantec without delay.

### Consultant

### Notes

F	ADDENDUM S01	KL	QW	2023.08.11
E	ISSUED FOR TENDER	KL	QW	2023.06.27
D	TENDER - FOR REVIEW	KL	QW	2023.05.24
C	ISSUED FOR 100% REVIEW	KL	QW	2023.04.19
B	ISSUED FOR 90% REVIEW	KL	QW	2023.02.27
A	ISSUED FOR 50% REVIEW	KL	QW	2022.11.10

Issued/Revision By Appd YYYY.MM.DD

File Name: N/A	KL	QW	DC	10/26/22
	Dwn.	Dsgn.	Chkd.	YYYY.MM.DD

### Permit/Seal

### Client/Project Logo



Client/Project  
CITY OF IQALUIT

LIFT STATION NO. 1, SEPTAGE RECEIVING  
STATION AND LOWER IQALUIT SEWER

Iqaluit, Nunavut

### Title

STRUCTURAL  
LIFT STATION NO. 1  
MAIN FLOOR FRAMING PLAN

Project No. 1101 000074 Scale As indicated

Revision F Drawing No. S-103



The Copyrights to all designs and drawings are the property of Stantec. Reproduction or use for any purpose other than that authorized by Stantec is forbidden. The Contractor shall verify and be responsible for all dimensions. DO NOT scale the drawing - any errors or omissions shall be reported to Stantec without delay.

---

Notes

F	ADDENDUM 501		KL	QW	2023.08.11
E	ISSUED FOR TENDER		KL	QW	2023.06.27
D	TENDER - FOR REVIEW		KL	QW	2023.05.24
C	ISSUED FOR 100% REVIEW		KL	QW	2023.04.19
B	ISSUED FOR 90% REVIEW		KL	QW	2023.02.27
A	ISSUED FOR 50% REVIEW		KL	QW	2022.11.10
Issued/Revision			By	Appd	YYYY.MM.DD
File Name: N/A			KL	QW	10/26/22
			Dwn.	Dsgn.	Chkd. YYYY.MM.DD



**S-10**



WOOD FRAMING NOTES:

1. REFER TO DESIGN NOTES AND DESIGN TALBES SERIES S00X.
2. REFER TO TYPICAL DETAILS SERIES S40X.
3. EXTERIOR WALL TO BE 38x140 (2x6) @ 406 (16") WALL, C/W 16mm PLYWOOD SHEATHING EACH SIDE, FASTEN ALL SHEATHING WITH 3.25 DIA. X 64 LONG COMMON WIRE NAILS @ 150 AT PANEL EDGES AND 300 ALONG INTERMEDIATE FRAMING MEMBERS.
4. FASTEN ALL 16mm PLYWOOD ROOF SHEATHING WITH 3.25 DIA. X 64 LONG COMMON WIRE NAILS @ 150 AT PANEL EDGES AND 300 ALONG INTERMEDIATE FRAMING MEMBERS.




F	ADDENDUM S01	KL	QW	2023.08.11
E	ISSUED FOR TENDER	KL	QW	2023.06.27
D	TENDER - FOR REVIEW	KL	QW	2023.05.24
C	ISSUED FOR 100% REVIEW	KL	QW	2023.04.19
B	ISSUED FOR 90% REVIEW	KL	QW	2023.02.27
A	ISSUED FOR 50% REVIEW	KL	QW	2022.11.10

Issued/Revision	By	Appd	YYYY.MM.DD
File Name: N/A	KL	QW	DC
	Dwn.	Dsgn.	Chkd.
			YYYY.MM.DD

Permit/Seal

Client/Project Logo



Client/Project  
CITY OF IQALUIT


LIFT STATION NO. 1, SEPTAGE RECEIVING  
STATION AND LOWER IQALUIT SEWER

Iqaluit, Nunavut

Title

STRUCTURAL  
LIFT STATION NO. 1  
SECTIONS AND DETAILS SHEET 1 OF 3

Project No.	Scale
1101 000074	1 : 20
Revision	Drawing No.
F	S-301

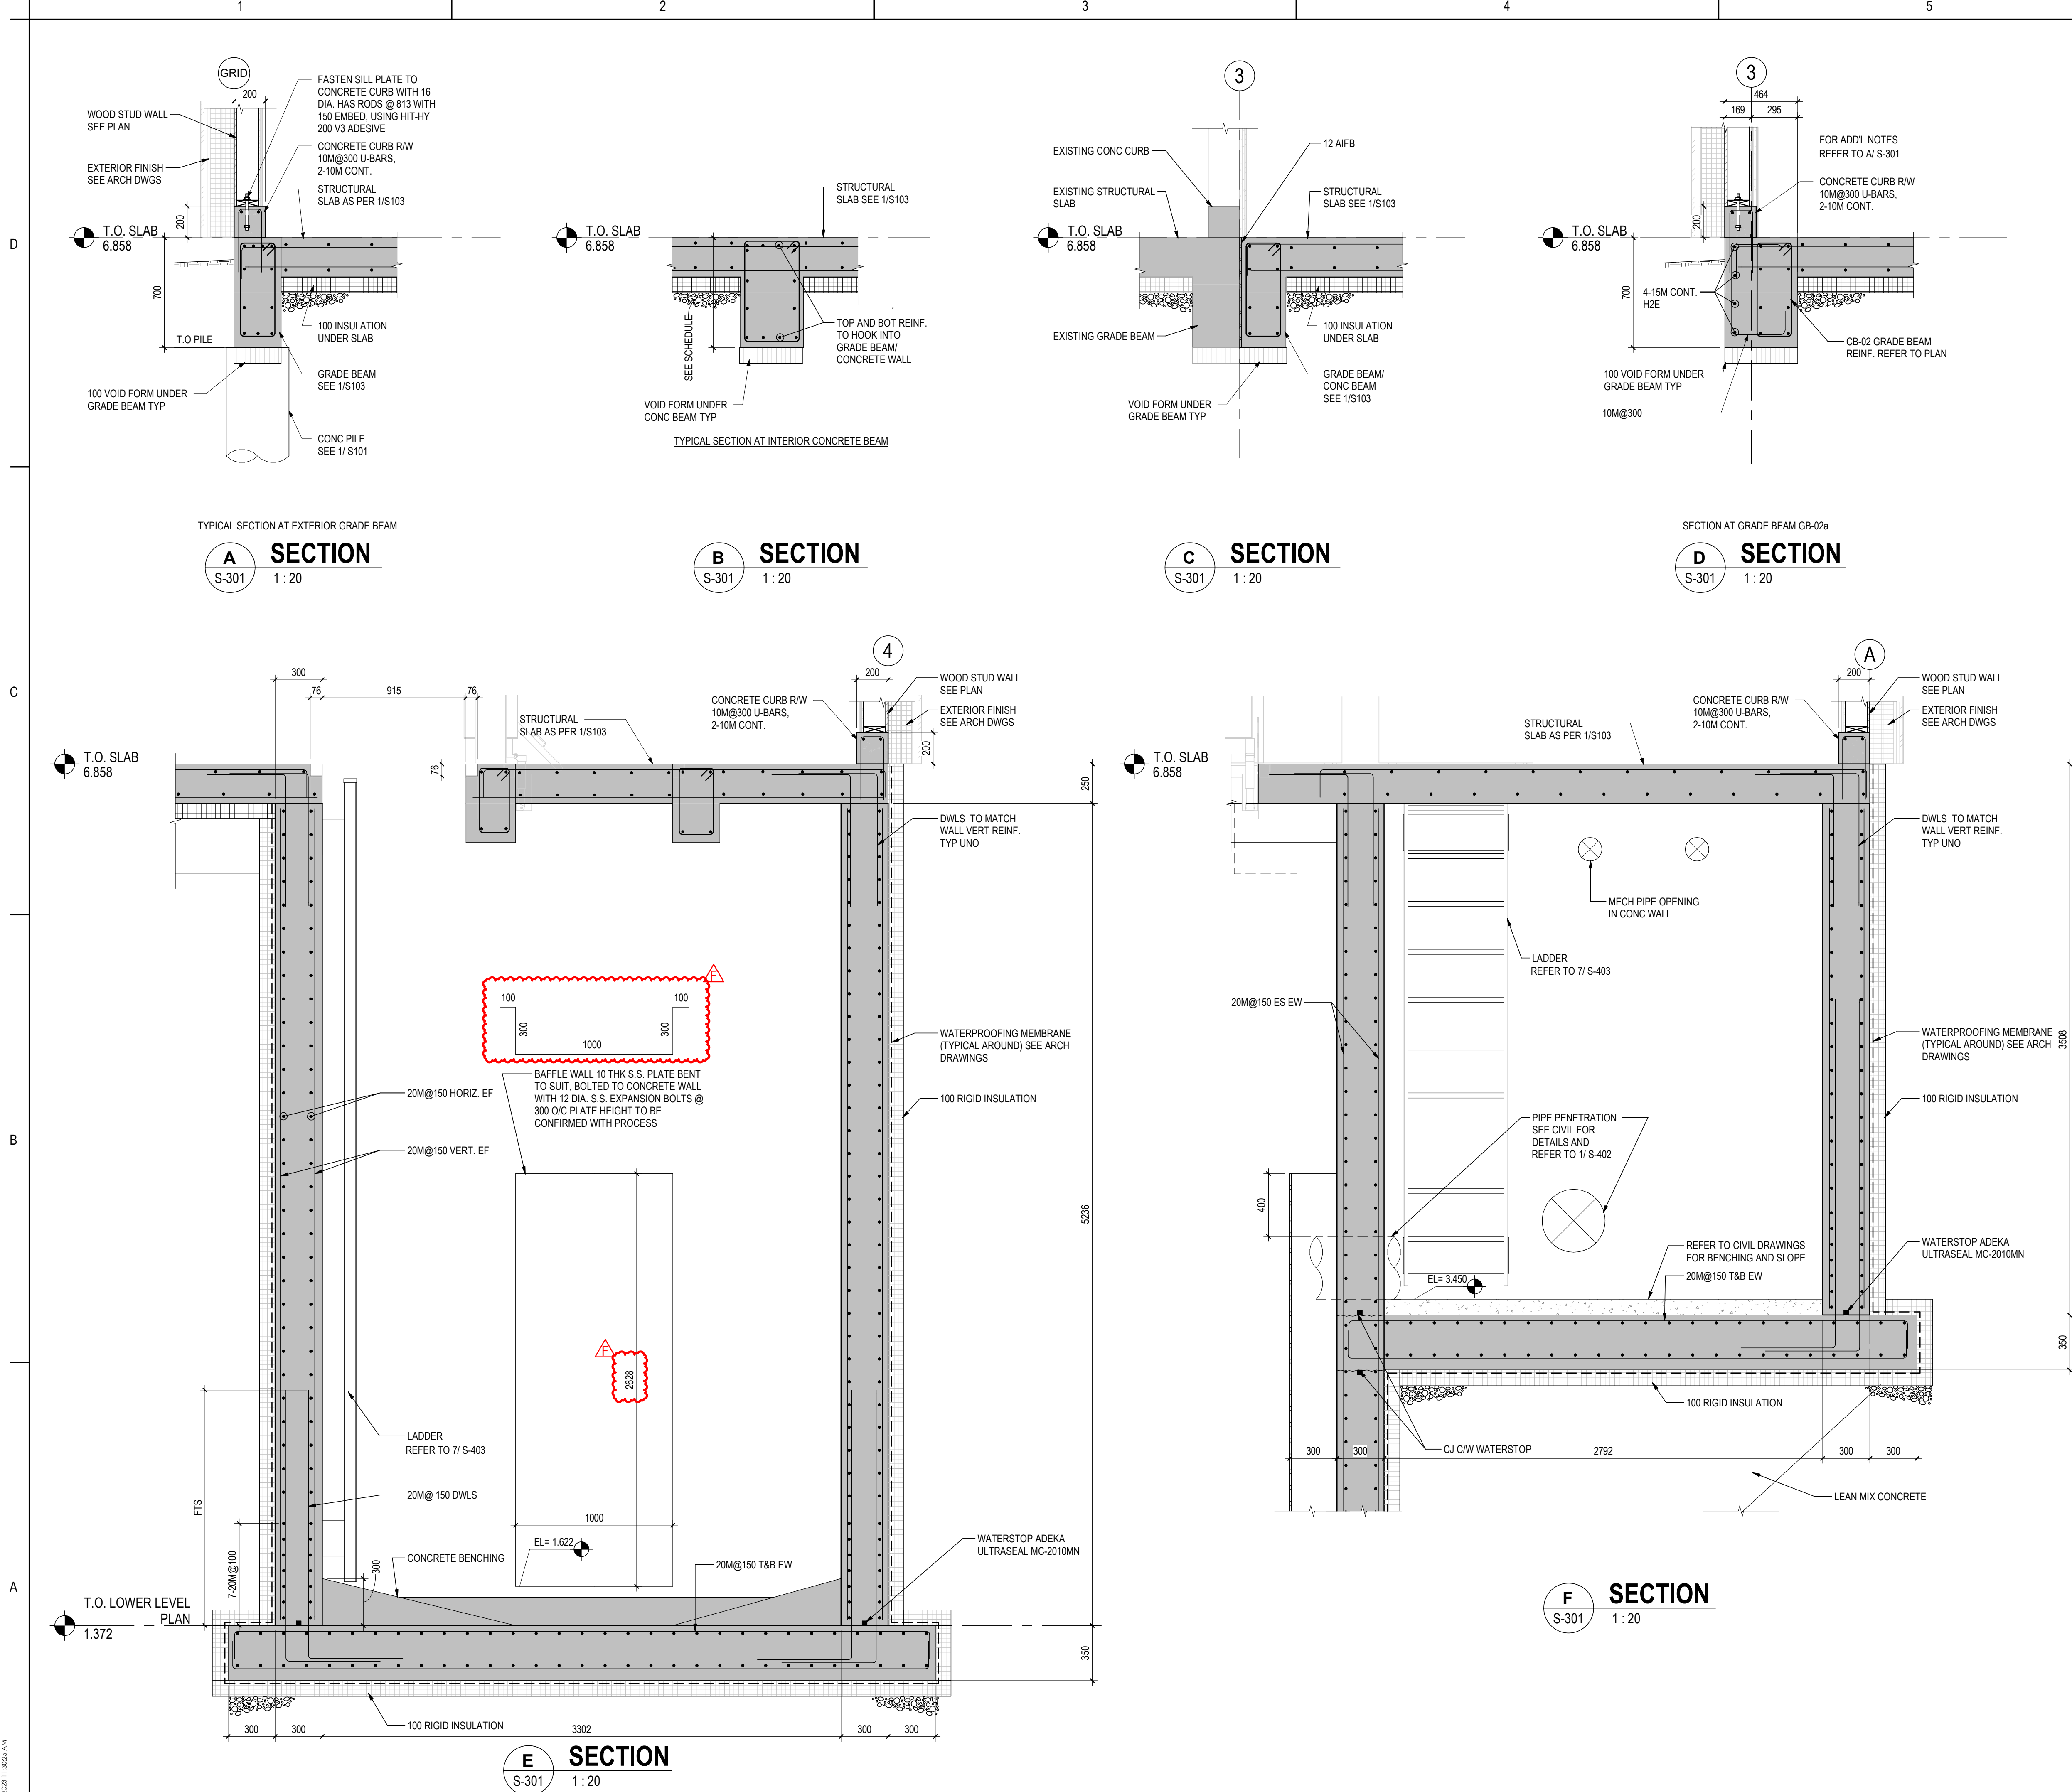




D

C

B

A

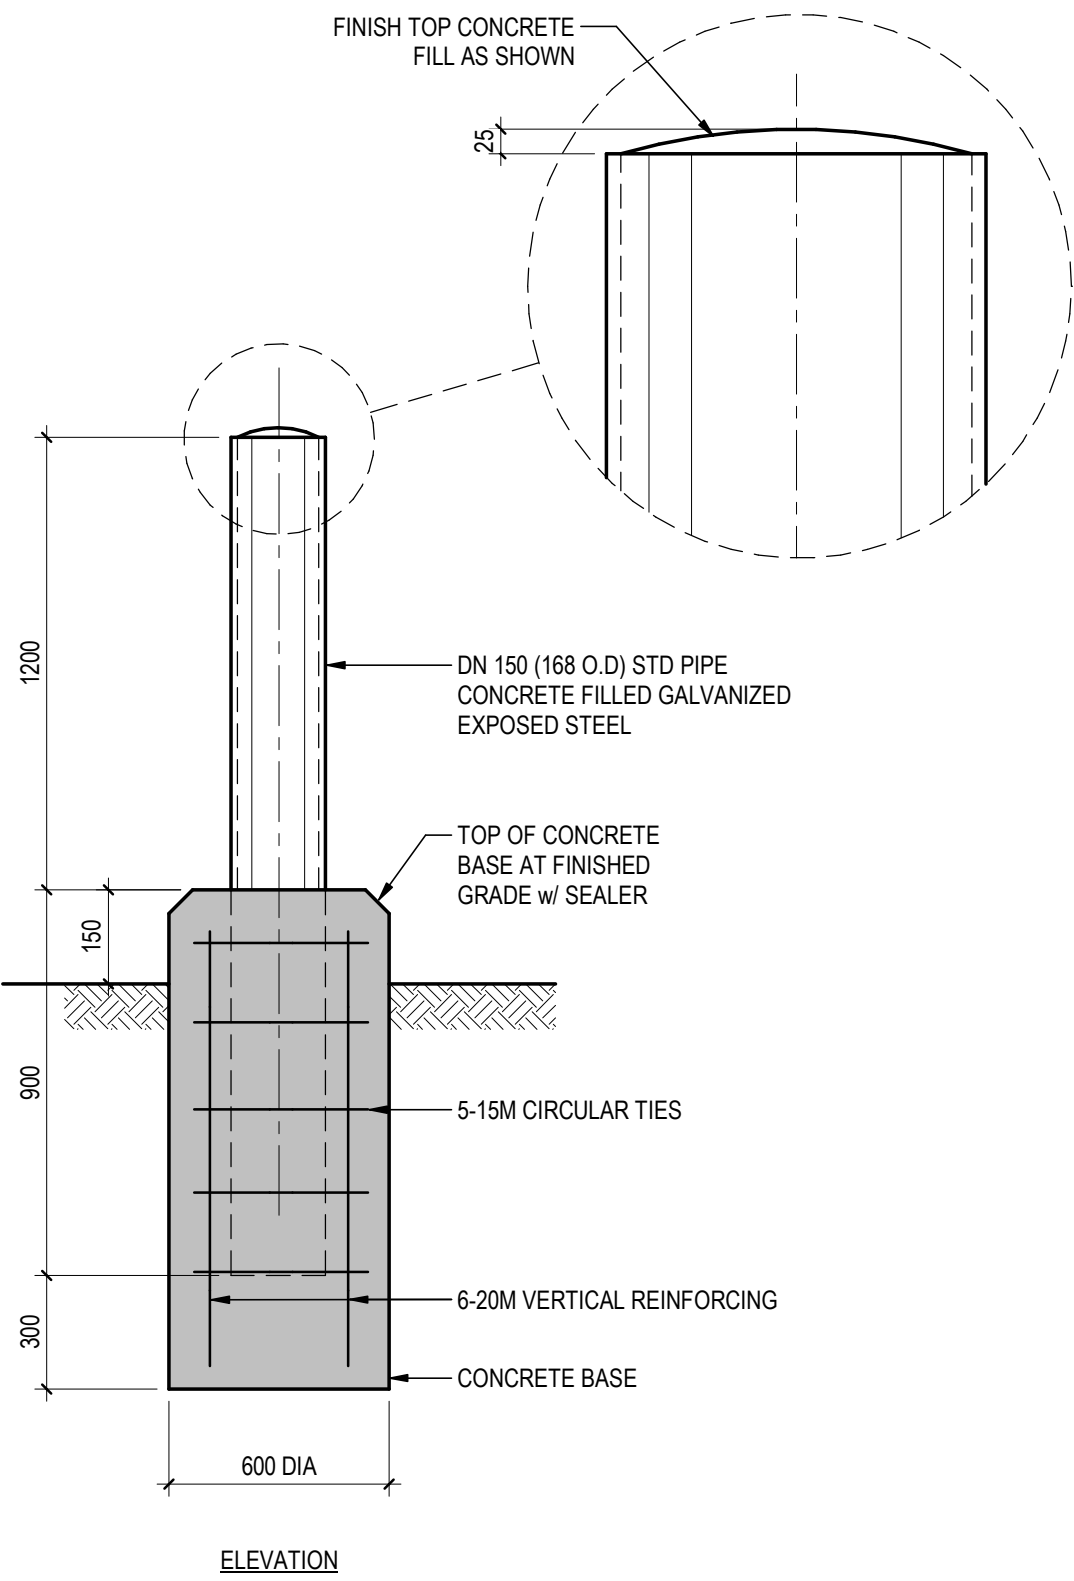


**TYPICAL SELF SUPPORTED BOLLARD  
DETAIL**

1

S-405

NTS

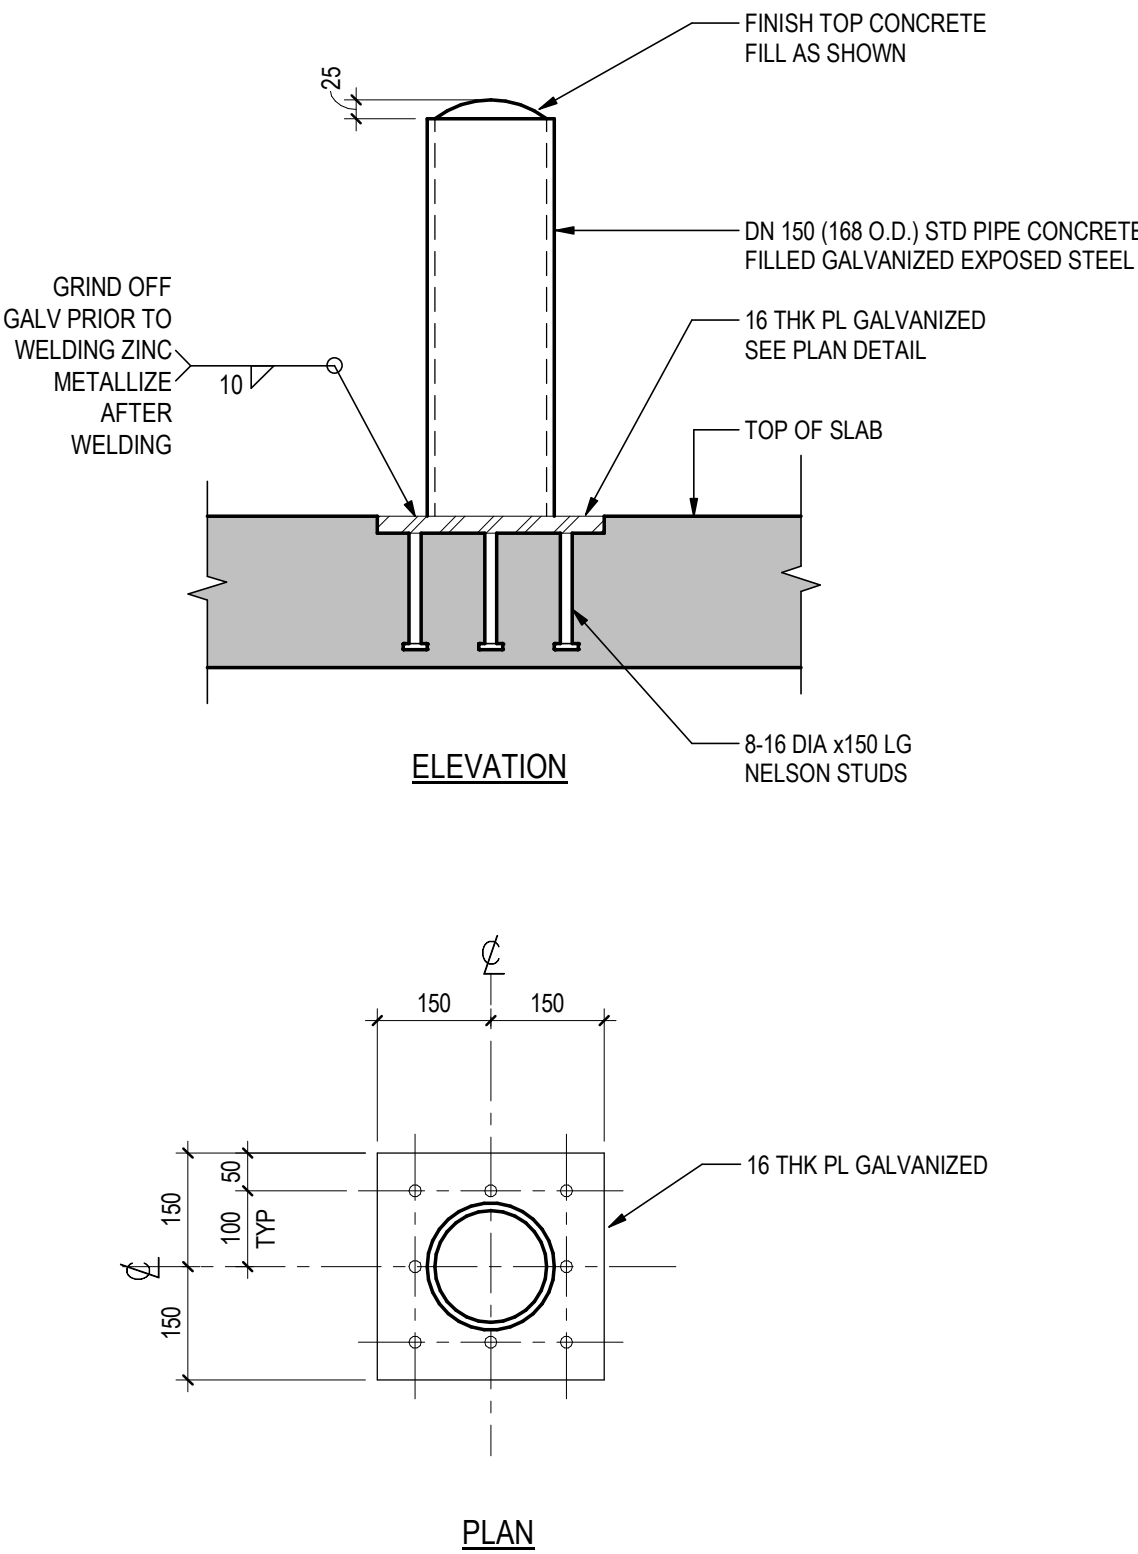


**TYPICAL SLAB SUPPORTED BOLLARD**

2

S-405

NTS

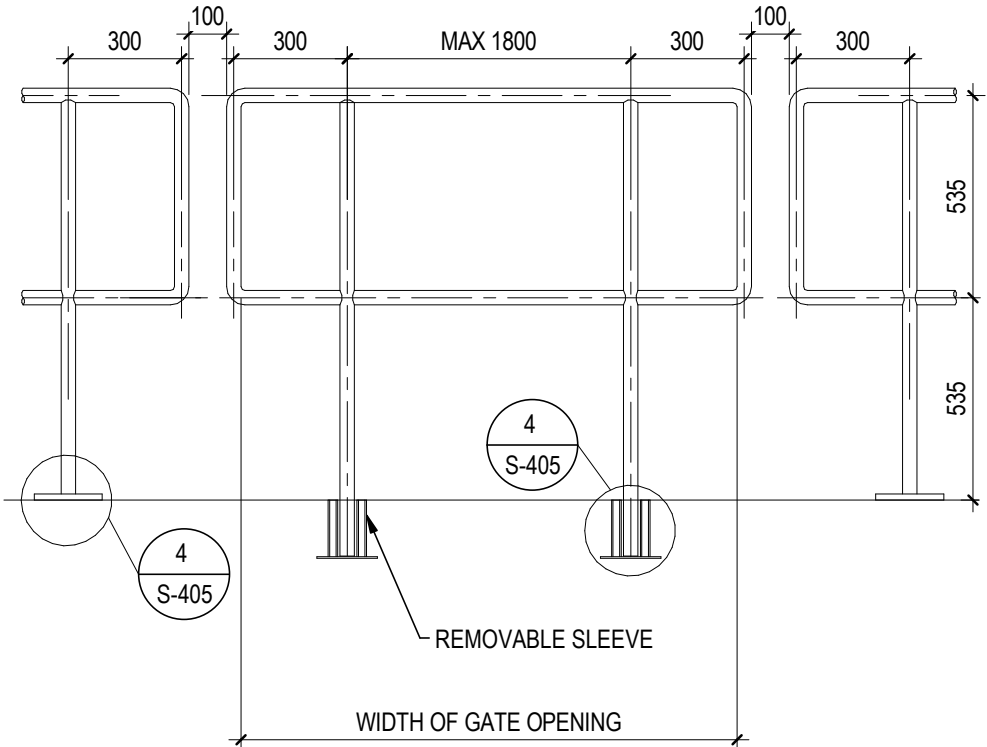


**TYPICAL REMOVABLE HANDRAIL SECTION**

3

S-405

NTS

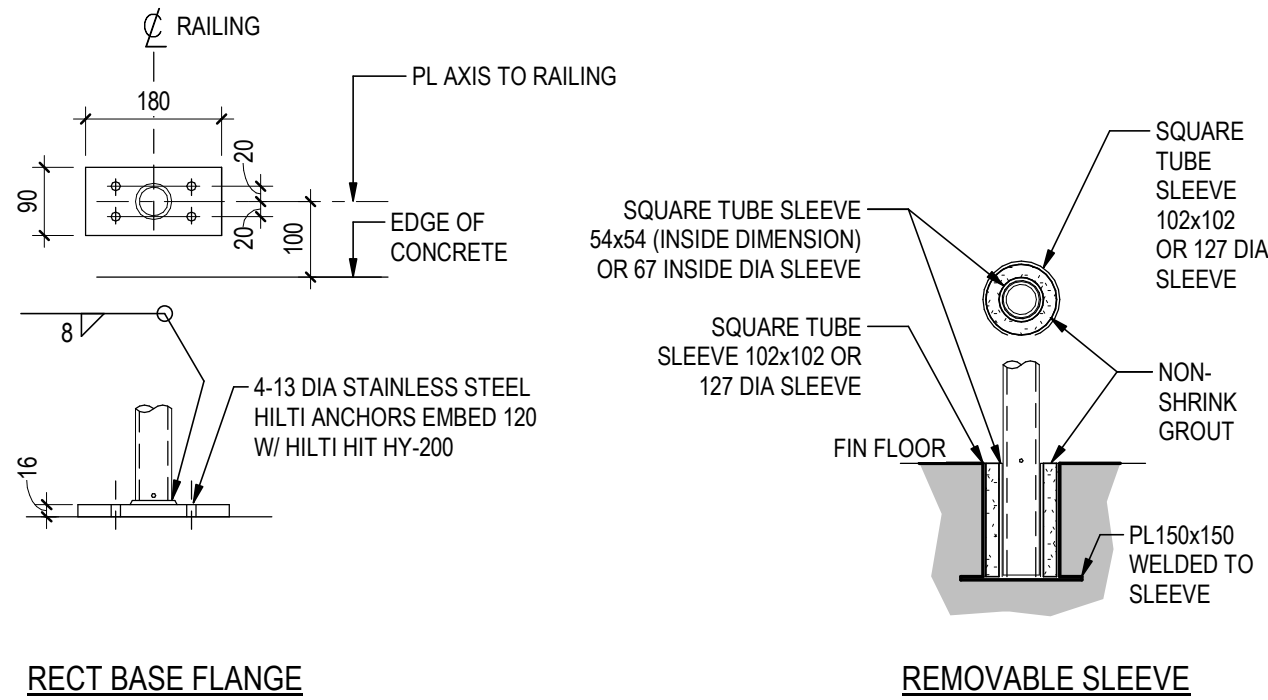

**TYPICAL ALUMINUM RAILING CONNECTION DETAILS TO CONCRETE**

4

S-405

NTS



Stantec Consulting Ltd.  
1088C Noble House  
PO Box 1779  
Iqaluit, NU X0A 0H0  
Tel: (867) 979-0555 • www.stantec.com

Copyright Reserved

The Copyrights to all designs and drawings are the property of Stantec. Reproduction or use for any purpose other than that authorized by Stantec is forbidden. The Contractor shall verify and be responsible for all dimensions. DO NOT scale the drawing - any errors or omissions shall be reported to Stantec without delay.

Consultant

Notes

D	ADDENDUM S01	KL	QW	2023.08.11
C	ISSUED FOR TENDER	KL	QW	2023.06.27
B	TENDER - FOR REVIEW	KL	QW	2023.05.24
A	ISSUED FOR 100% REVIEW	KL	QW	2023.04.19
Issued/Revision		By	Appd	YYYY.MM.DD
File Name: N/A		KL	QW	DC
		Dwn.	Dsgn.	Chkd.
				YYYY.MM.DD

Permit/Seal

Client/Project Logo



Client/Project

CITY OF IQALUIT

LIFT STATION NO. 1, SEPTAGE RECEIVING  
STATION AND LOWER IQALUIT SEWER

Iqaluit, Nunavut

Title

STRUCTURAL  
LIFT STATION NO. 1  
TYPICAL DETAILS SHEET 5 OF 5

Project No.

1101 000074

Revision

D

Drawing No.

Scale

As indicated

**S-405**






# CITY OF IQALUIT

ᐃᑦᑲᑭᐃᑦ ᐃᑦᑲᑭᐃᑦ ᐃᑦᑲᑭᐃᑦ

## LIFT STATION NO. 1 TEMPORARY BYPASS

### INDEX OF INCLUDED DRAWINGS

DRAWING NO.	REVISION	DESCRIPTION
		COVER SHEET
FRN-21005203-A0 - 46-1	C	P&ID, SYMBOLS, LEGEND AND ABBREVIATIONS
FRN-21005203-A0 - 46-2	C	TEMPORARY LIFT STATION SITE PLAN
FRN-21005203-A0 - 46-2A	A	BYPASS CONNECTION AND LIFT STATION MODIFICATION
FRN-21005203-A0 - 46-3	C	TEMPORARY LIFT STATION PLAN AND SECTION
FRN-21005203-A0 - 46-4	C	TEMPORARY EQUALIZATION TANK SECTION
FRN-21005203-A0 - 26-1	C	TEMPORARY LIFT STATION ELECTRICAL SITE PLAN
FRN-21005203-A0 - 26-2	C	TEMPORARY LIFT STATION ELECTRICAL DETAILS

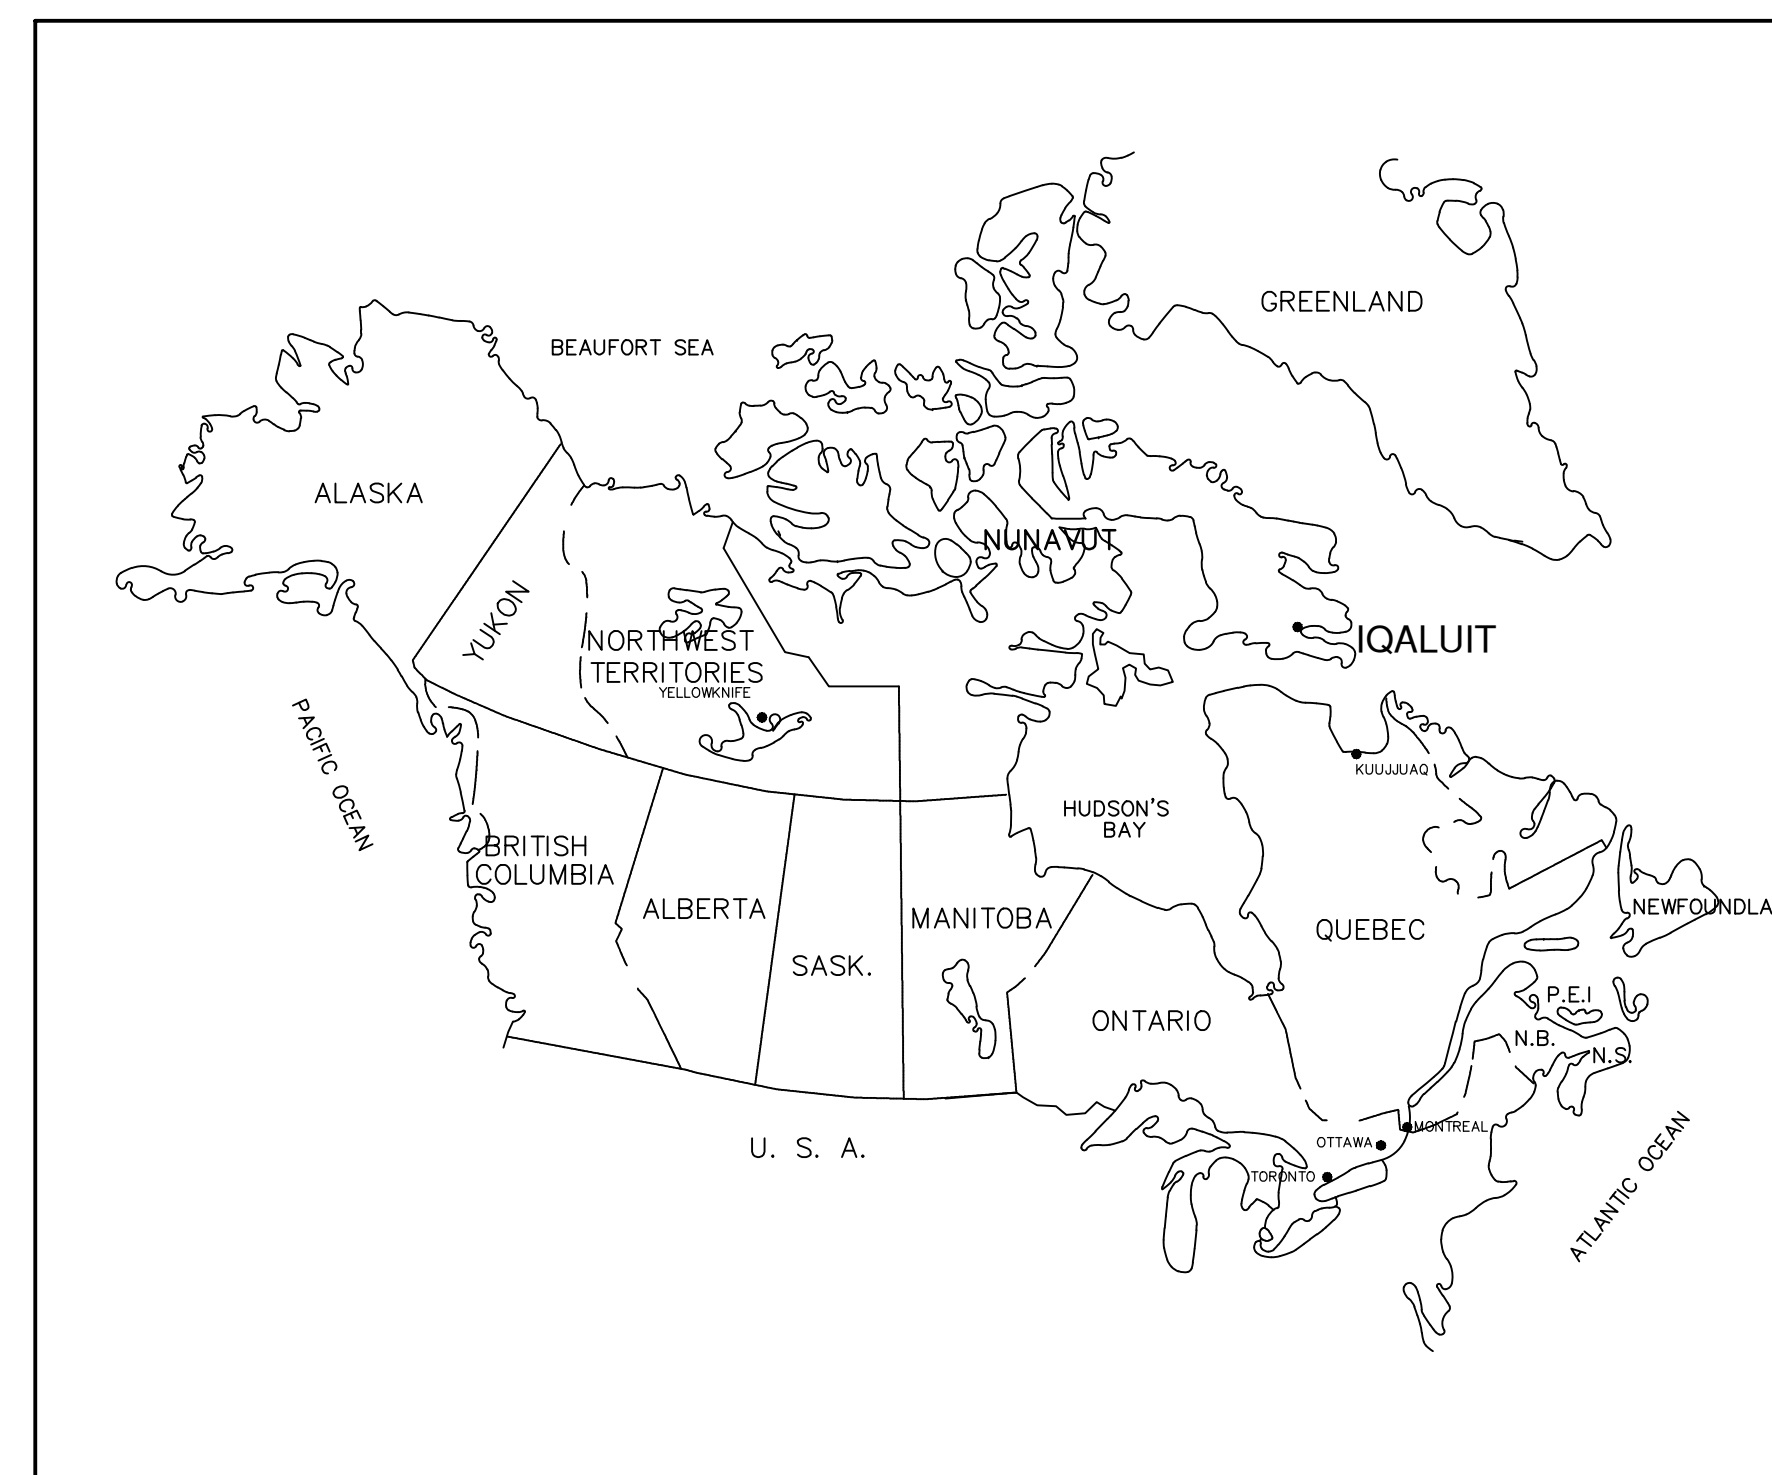

### AS-BUILT DRAWING

AS-BUILT DRAWING INFORMATION PROVIDED BY  
NUNAVUT EXCAVATING LTD. TO EXP SERVICES INC.  
NO FIELD VERIFICATION WAS EXECUTED BY EXP.

## AS-BUILT DRAWINGS - JANUARY 2023

exp Services Inc.  
T: +1.613.688.1899 | F: +1.613.225.7330  
2650 Queensview Drive, Unit 100  
Ottawa, ON K2B 8H6  
Canada

www.exp.com




• BUILDINGS • EARTH & ENVIRONMENT • ENERGY •  
• INDUSTRIAL • INFRASTRUCTURE • SUSTAINABILITY •

\\EXPDATA\OTFRN\21005203-A0\B01\EXECUTIONS\DRAWINGS\PI\PID, SYMBOLS, LEGEND AND ABBREVIATIONS  
ALAN FINLAY

ABBREVIATIONS

AA- ANALYSIS ALARM AAV- AUTOMATIC AIR VENT AC- ANALYSIS CONTROL OR AIR COMPRESSION AE- ANALYSIS ELEMENT AHLR- ALARM HIGH/LOW RECORDING AH- ALARM HIGH AHH- ALARM HIGH/HIGH AI- ANALYSIS INDICATOR AIR- AIR AIT- ANALYSIS INDICATING TRANSMITTER AL- ALARM LOW ALL- ALARM LOW/LOW AM- AUGER MOTOR AOV- AIR OPERATED VALVE ARI- ANALYSIS RECORDER ARI- ANALYSIS RECORDER/INDICATOR OR ANAEROBIC REACTOR INFLUENT ART- AIR RECEIVER TANK ARVB- AIR RELIEF AND VACUUM BREAKER AS- AUTOMATIC SAMPLER BC- BELT CONVEYOR BF- BACK FLUSH BP- BOOSTER PUMP BPV- BACK PRESSURE VALVE BS- BASKET SCREEN BSP- BUILDING SUMP PUMP BSV- BLOCKING SAFETY VALVE BVF- BULK VOLUME FERMENTER BV- BUTTERFLY VALVE BWP- BOOSTER WATER PUMP CA- COMPRESSED AIR CAD- COMPRESSED AIR DRYER CG- CALIBRATION COLUMN CD- CONDENSATE DRAIN CF- CARTRIDGE FILTER CFB- CARTRIDGE FILTER BANK CFP- CHEMICAL FEED PANEL CHK- CHECK VALVE CL- CLASS OR CHLORINE CP- CHEMICAL PUMP CS- CONTROL STATION CV- CONTROL VALVE DCS- DISTRIBUTED CONTROL SYSTEM DO- DISSOLVED OXYGEN DP- DISTRIBUTION PUMP DPG- DIFFERENTIAL PRESSURE GAUGE OR DIGITAL PRESSURE GAUGE DPT- DIFFERENTIAL PRESSURE TRANSMITTER DR- DRAIN DS- DRAIN SUMP DSP- DRAIN SUMP PUMP DT- DRIP TRAP EJ- EXPANSION JOINT EOF- EMERGENCY OVERFLOW EP- EMERGENCY PUMP ETK- EXPANSION TANK FA- FLOW ALARM FAL- FLOW ALARM LOW FC- FLOW CONTROLLER OR FLAME CHECK OR FLUSH CONNECTION FCV- FLOW CONTROL VALVE FD- FLOOR DRAIN FDS- FINE DRUM SCREEN FE- FLOW ELEMENT FI- FLOW INDICATOR FIT- FLOW INDICATING TRANSMITTER FLV- FLOAT VALVE FM- FLOWMETER FP- FIRE PUMP FQI- FLOW QUANTITY INDICATOR FOR- FLOW QUANTITY RECORDER FORI- FLOW QUANTITY RECORDER/INDICATOR FV- FILL VALVE OR FOOT VALVE FW- FLUSH WATER GEC- GAS ELIMINATION CHAMBER GG- GAUGE GUARD	GV&B- GATE VALVE & BOX H- HORN HB- HOSE BIBB HP- HEATING PUMP HS- HAND SWITCH HX- HEAT EXCHANGER IC- CURRENT CONTROLLER INF- INFLUENT INJ- VENTURI INJECTOR IP- INFLUENT PUMP IT- CURRENT TRANSMITTER IV- INJECTION VALVE JP- JOCKEY PUMP JRC- JET RECIRCULATION JRP- JET RECIRCULATION PUMP KC- TIMER CONTROLLER LA- LEVEL ALARM LAH- LEVEL ALARM HIGH LAL- LEVEL ALARM LOW LAHL- LEVEL ALARM HIGH/LOW LAR- LEVEL ALARM RECORDER INDICATOR LC- LEVEL CONTROLLER LCP- LOCAL CONTROL PANEL LE- LEVEL ELEMENT LI- LEVEL INDICATOR LIT- LEVEL INDICATING TRANSMITTER LPS- LADDER PIPE SUPPORT LRC- LEVEL RECORDER LRI- LEVEL RECORDER/INDICATOR LS- LEVEL SWITCH LSC- LEVEL SWITCH CLOSED LSH- LEVEL SWITCH HIGH LSL- LEVEL SWITCH LOW MCV- MODULATING CONTROL VALVE MF- MEDIA FILTER MFV- MULTI-FUNCTION VALVE MIX- MIXER MV- MOTORIZED VALVE NC- NORMALLY CLOSED NO- NORMALLY OPEN NTU- TURBIDITY NWL- NORMAL WATER LEVEL OCV- OPEN/CLOSE VALVE ORP- OXIDATION REDUCTION POTENTIAL SENSOR OVF- OVERFLOW PAH- PRESSURE ALARM HIGH PAL- PRESSURE ALARM LOW PAM- POLYMER SYSTEM PC- PRESSURE CONTROLLER PE- PRESSURE ELEMENT PG- PRESSURE GAUGE OR PROPANE GAS PH/T- PH AND TEMPERATURE PIT- PRESSURE INDICATING TRANSMITTER PRI- PRESSURE RECORDER/INDICATOR PRV- PRESSURE RELIEF, REGULATING OR REDUCING VALVE PS- PRESSURE SWITCH PSH- PRESSURE SWITCH HIGH PT- PRESSURE TRANSMITTER PV- PINCH VALVE QC- QUICK CONNECT RP- RECLAIM PUMP RSP- REMOVABLE SUMP PUMP S- SOLENOID SA- SAMPLE SAMH- SANITARY MANHOLE SARV- SEWAGE AIR RELIEF VALVE SC- SPEED CONTROLLER/VFD OR SCREEN SFB- SINGLE FUEL BOILER SG- SUCTION GUIDE OR SIGHT GLASS SM- STATIC MIXER SMP- SAMPLER PUMP SP- SAMPLE POINT OR SOLUTION PUMP ST- SAMPLE TAP SV- SOLENOID VALVE T- TEMPERATURE	TA- TEMPERATURE ALARM TAH- TEMPERATURE ALARM HIGH TC- TEMPERATURE CONTROLLER TE- TEMPERATURE ELEMENT TG- TEMPERATURE GAUGE TI- TEMPERATURE INDICATOR TT- TEMPERATURE INDICATING TRANSMITTER TIS- TEMPERATURE INDICATING SWITCH TK- TANK TRI- TEMPERATURE TRANSMITTER TS- TEMPERATURE SWITCH OR TUBE SETTLER TT- TEMPERATURE TRANSMITTER V- VALVE VFD- VARIABLE FREQUENCY DRIVE VT- VENT W- WATER YA- EVENT ALARM YC- EVENT/STATUS CONTROLLER YS- EVENT SWITCH ZS- LIMIT SWITCH ZSL- LIMIT SWITCH LOW ZSO- LIMIT SWITCH CLOSED ZSO- LIMIT SWITCH OPEN ZSOC- LIMIT SWITCH OPEN/CLOSED
---	---	--

PLC AND DEVICE LEGEND

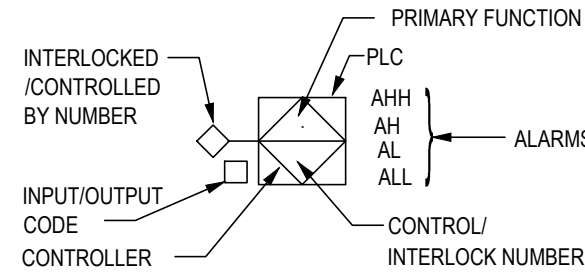

PLC I/O

<b>A</b> 1 DISCRETE OUTPUT	<b>G</b> 1 ANALOG OUTPUT	<b>DEVICENET</b>
<b>B</b> 1 DISCRETE OUTPUT 2 DISCRETE INPUTS	<b>H</b> 1 ANALOG OUTPUT 1 DISCRETE INPUT	<b>INTERLOCKS USED: 1-</b>
<b>C</b> 1 DISCRETE INPUT	<b>I</b> 1 ANALOG OUTPUT	
<b>D</b> 1 ANALOG INPUT	<b>J</b> 2 DISCRETE OUTPUT	
<b>E</b> 1 DISCRETE OUTPUT 2 DISCRETE INPUTS 1 ANALOG OUTPUT	<b>K</b> 4 DISCRETE INPUTS 2 ANALOG INPUTS	

PROCESS AREA IDENTIFIERS


IDENTIFIER	DESCRIPTION	IDENTIFIER	DESCRIPTION
10	LOW PRESSURE		
20	HIGH PRESSURE		
30	RECIRCULATION		

PLC SYMBOLS		CONTROL PANELS		INSTRUMENT SYMBOLS	
	FIELD MOUNTED		FIELD MOUNTED		SINGLE DEVICE FIELD MOUNTED
	PRIMARY REMOTE LOCATION		PRIMARY REMOTE LOCATION		MULTIPLE DEVICES INTEGRALLY CONNECTED
					MULTIPLE DEVICES REMOТЕLY CONNECTED

EQUIPMENT IDENTIFICATION PROCEDURE

<b>NN</b> <b>DDD</b> <b>#</b>	INSTRUMENT OR PRIMARY SENSING ELEMENT
NN:	TWO DIGIT PROCESS AREA NUMBER. THIS IS USED TO IDENTIFY THE AREA OF THE PROCESS IN WHICH THE EQUIPMENT IS USED RATHER THAN THE AREA IN WHICH IT IS LOCATED.
DDDD:	DEVICE DESCRIPTION FROM LEGEND IN AREA NN. EG., THE FIRST PG IN THE SYSTEM IS 10-PG-01; ETC.
#:	DEVICE/EQUIPMENT NUMBER

INFORMATION BLOCKS

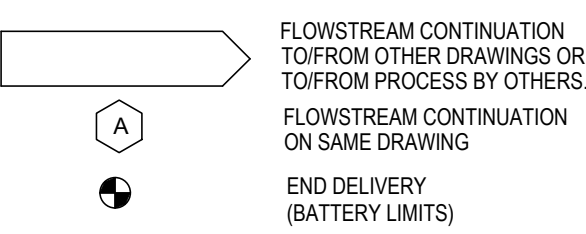

EQUIPMENT & PIPING ACCESSORIES

AIR FILTER PIPE CAP OR PLUG COUPLING BLIND FLANGE (N-LINE) BLIND FLANGE COMPENSATOR DRAIN SPRAY NOZZLE VENT PULSE ABSORBER VENTURI INJECTOR UNION SIPHON SIGHT-GLASS WITH FLOW READING SIGHT-GLASS FLEXIBLE CONNECTOR FLEXIBLE CONNECTING REDUCER CONCENTRIC REDUCER ECCENTRIC REDUCER TRUCK CONNECTION GRAVITY FLOW JET MIX / JET AERATION SILENCER SPRAY NOZZLE HEADER CONDENSATE OR DRIP TRAP STRAINER STATIC MIXER BRAIDED HOSE	CLEANOUT PURGE POINT DECANter BASKET SCREEN LIQUID SEAL HEAT EXCHANGER GAUGE GUARD SEDIMENT MOISTURE TRAP AIR RELIEF VALVE AND BREAKER HOSE CONNECTION PUMP POSITIVE DISPLACEMENT PUMP IMPELLER TYPE MIXER COMPRESSOR FLOOR DRAIN FLOW METER HOSE CONNECTOR BACK FLOW PREVENTER FLOW DIRECTION
---	--


VALVES

	VALVE (BASIC SYMBOL)
	BALL VALVE
	PLUG VALVE
	THREE WAY PLUG VALVE
	DIAPHRAGM VALVE
	NEEDLE VALVE
	KNIFE GATE VALVE
	BUTTERFLY VALVE
	CHECK VALVE
	FOOT VALVE
	THREE WAY COCK
	PRESSURE REDUCING VALVE
	PRESSURE RELIEF VALVE
	OVER PRESSURE RELIEF VALVE
	UNDER PRESSURE RELIEF VALVE
	ADJUSTABLE OVER PRESSURE RELIEF VALVE
	BACK PRESSURE VALVE
	PINCH VALVE
	LUBRICATED PLUG VALVE
	MOTOR ACTUATED
	DIAPHRAGM ACTUATED
	FLOAT CONTROLLED
	SPRING ACTUATED
	WEIGHT CONTROLLED
	SOLENOID VALVE
	PNEUMATIC CONTROL VALVE
	LOCKABLE ACTUATOR ON VALVE
	VENT VALVE
	PRESSURE REGULATOR
	MOTORIZED SAFETY SHUT-OFF VALVE
	SHUT-OFF COCK
	TWIN FLAPPER CHECK VALVE
	MULTI-FUNCTION VALVE
	GATE VALVE AND BOX
	BUTTERFLY VALVE AND BOX
	GLOBE VALVE
	PRESSURE REDUCING VALVE

DRIVER TYPE

<b>M</b>	ELECTRIC
<b>H</b>	HYDRAULIC
<b>P</b>	PNEUMATIC

NOTE: NOT ALL ABBREVIATIONS, LEGEND, SYMBOLS, VALVE TYPE, PROCESS ABBREVIATIONS, ETC APPLY

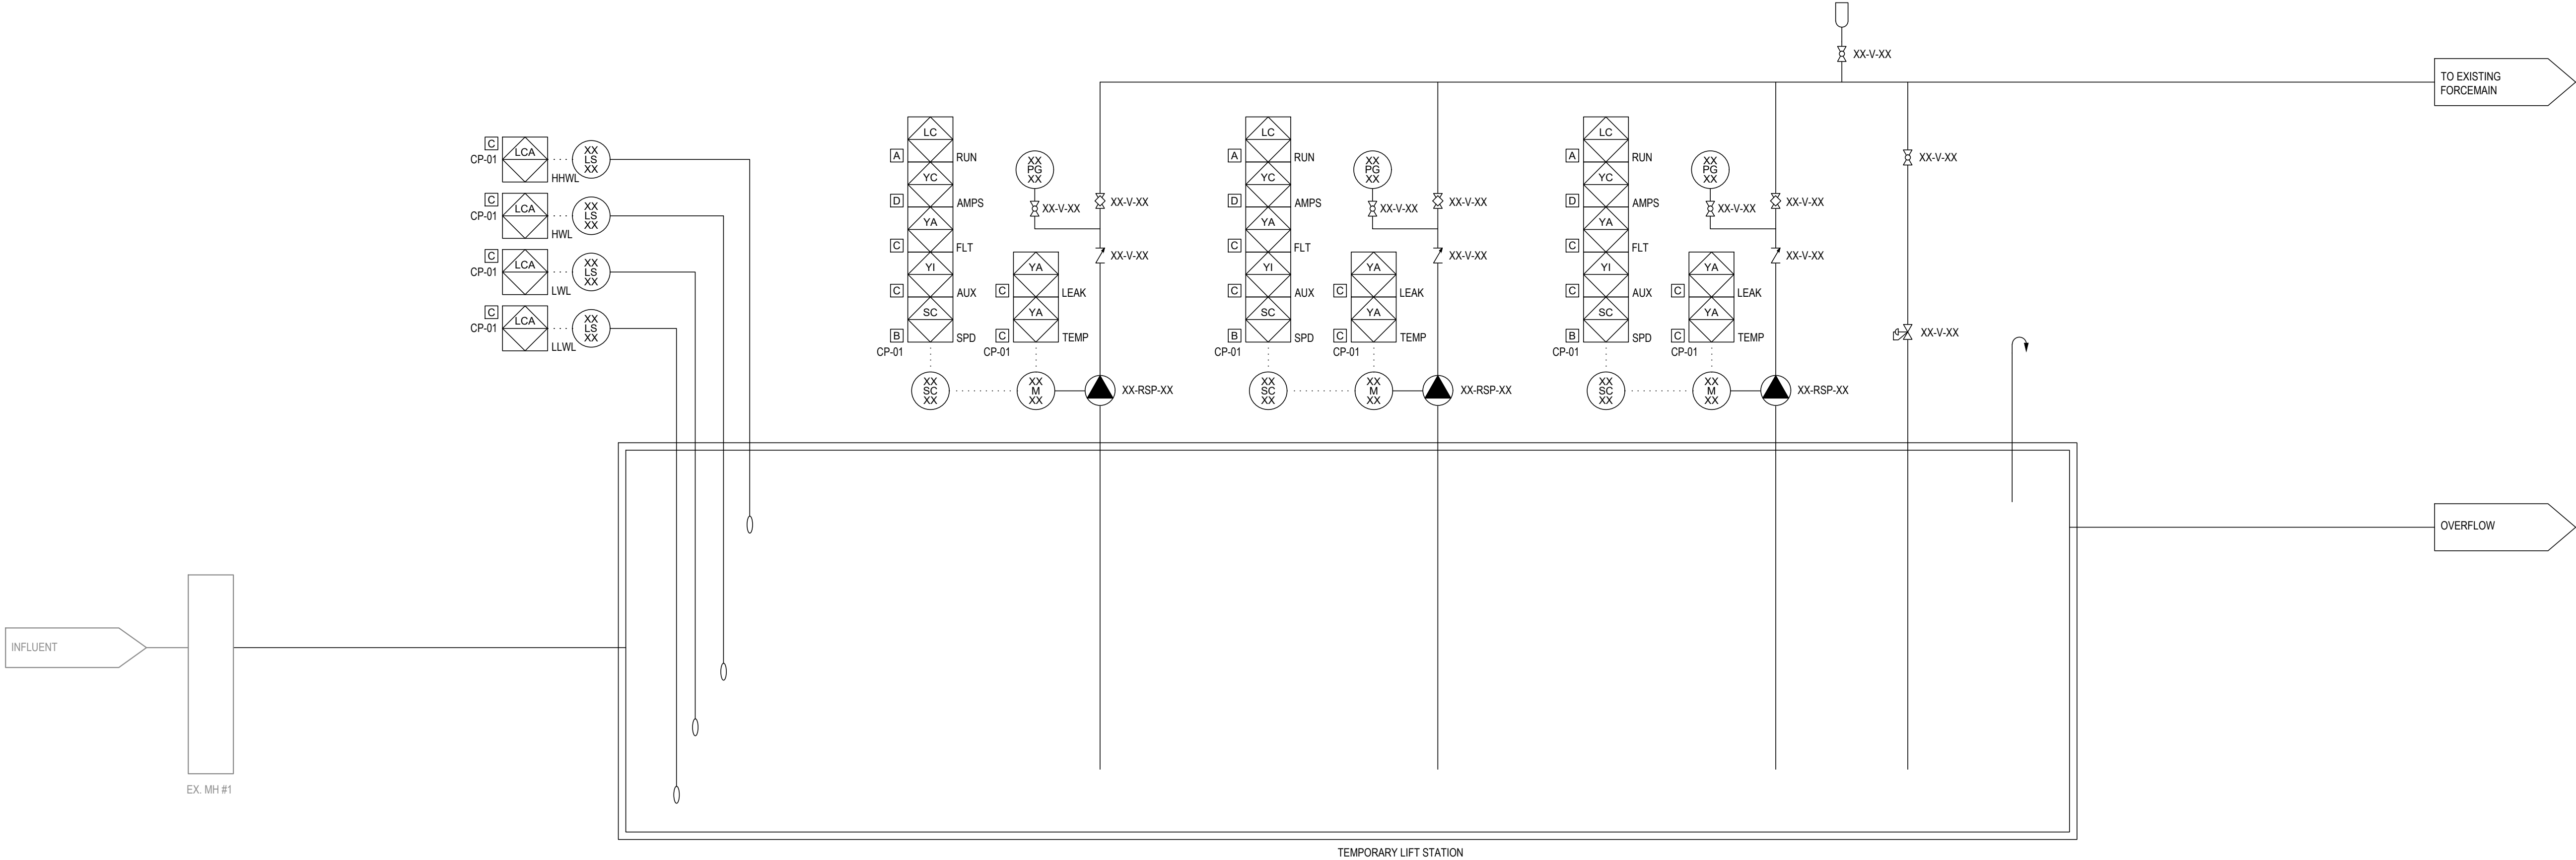

EXP Services Inc.  
T: +1 506 452 9000 F: +1 506 459 3954  
1133 Regent Street, Suite 300  
Fredericton, NB, E3B 3Z2  
CANADA  
[www.exp.com](http://www.exp.com)



• BUILDINGS • EARTH & ENVIRONMENT • ENERGY •  
• INDUSTRIAL • INFRASTRUCTURE • SUSTAINABILITY •

CAUTION: DO NOT SCALE DRAWINGS.  
THIS REPRODUCTION MAY BE AT A SIZE DIFFERENT THAN ORIGINALLY DRAWN. EXP ASSUMES  
NO RESPONSIBILITY FOR INCORRECT SCALING. UNAUTHORIZED REPRODUCTION OR REUSE IS  
STRICTLY PROHIBITED. NOT PUBLISHED - ALL RIGHTS RESERVED. EXP EXPRESSLY DISCLAIMS  
RESPONSIBILITY ARISING FROM UNAUTHORIZED USE OF THESE DRAWINGS AND NOTES.  
AUTHORIZATION MUST BE IN WRITING.

© EXP, 2020

No.	Issue	Date
A	ISSUED FOR REVIEW	2021.AUG.13
B	ISSUED FOR TENDER	2021.AUG.30
C	AS BUILT	2023.JAN.31

AS-BUILT  
DRAWING

AS-BUILT DRAWING INFORMATION PROVIDED BY  
NUNAVUT EXCAVATING LTD. TO EXP SERVICES INC.  
NO FIELD VERIFICATION WAS EXECUTED BY EXP.

No.	Revision	Date
-----	----------	------

AS-BUILT

Professional Seal(s)	
----------------------	--

Drawn By:	ARL
Dwg Standards Ckd By:	
Designed By:	EAB
Design Checked By:	
Scale:	AS SHOWN
Project Title	



LIFT STATION #1 BYPASS

P&ID, SYMBOLS, LEGEND  
AND ABBREVIATIONS


Project No. FRN-21005203-A0

Dwg. No.	Rev. No.
46-1	C



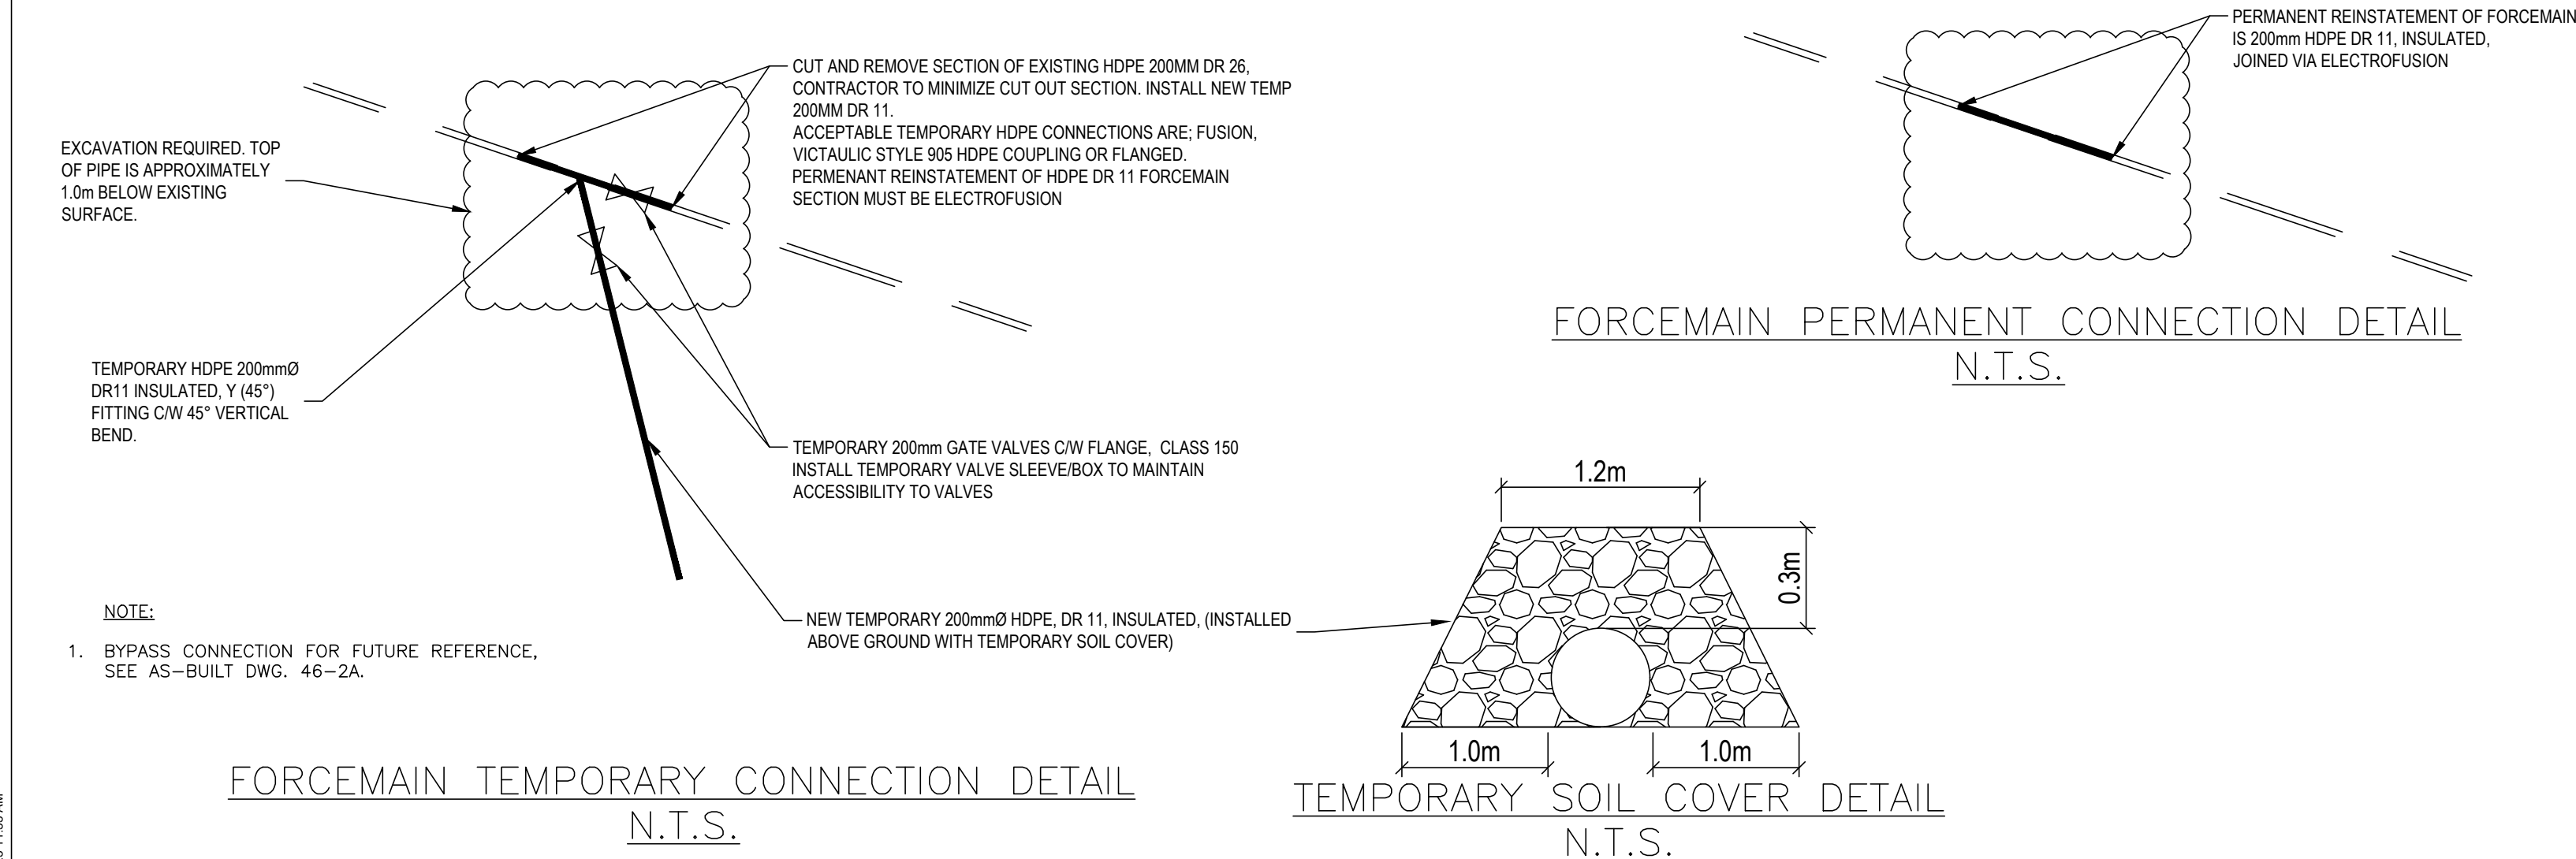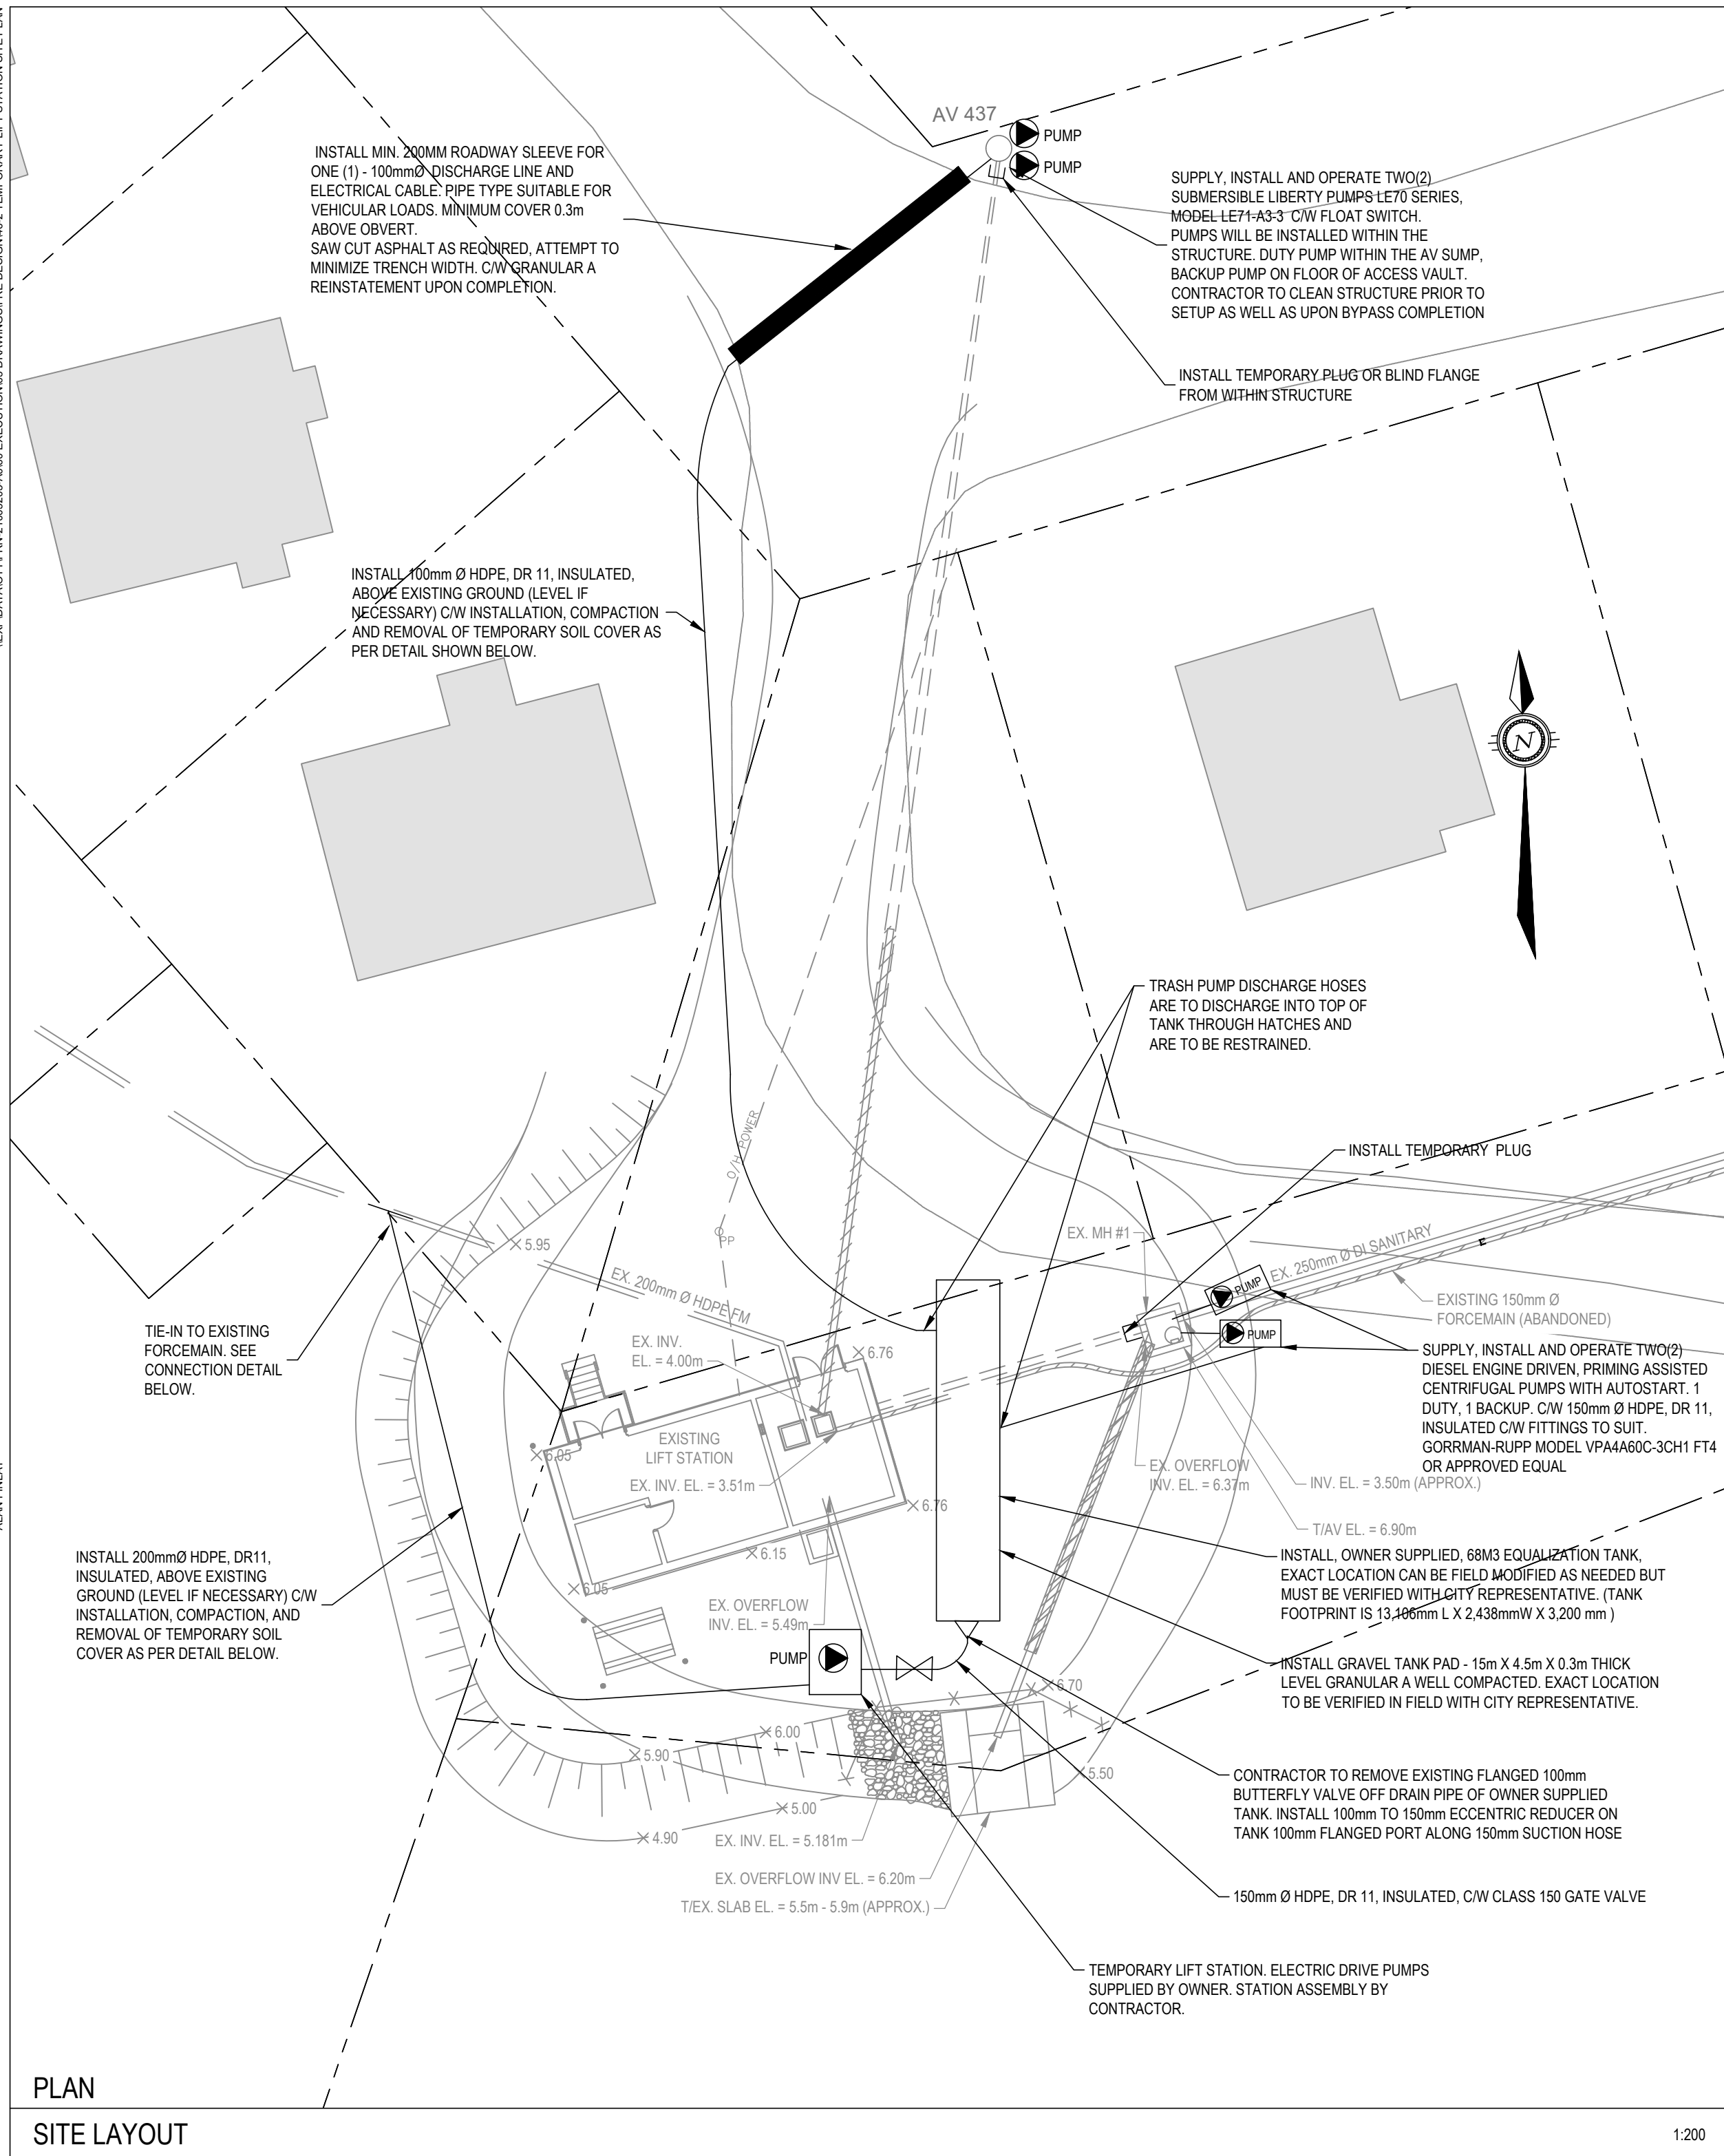


TEMPORARILY REMOVE EXISTING SEWER CLEANOUT, ALLOWING TWO INCOMING SEWERS TO SPILL INSIDE STRUCTURE. REINSTALL SANITARY CLEANOUT UPON COMPLETION OF BYPASS AND CLEAN INSIDE STRUCTURE

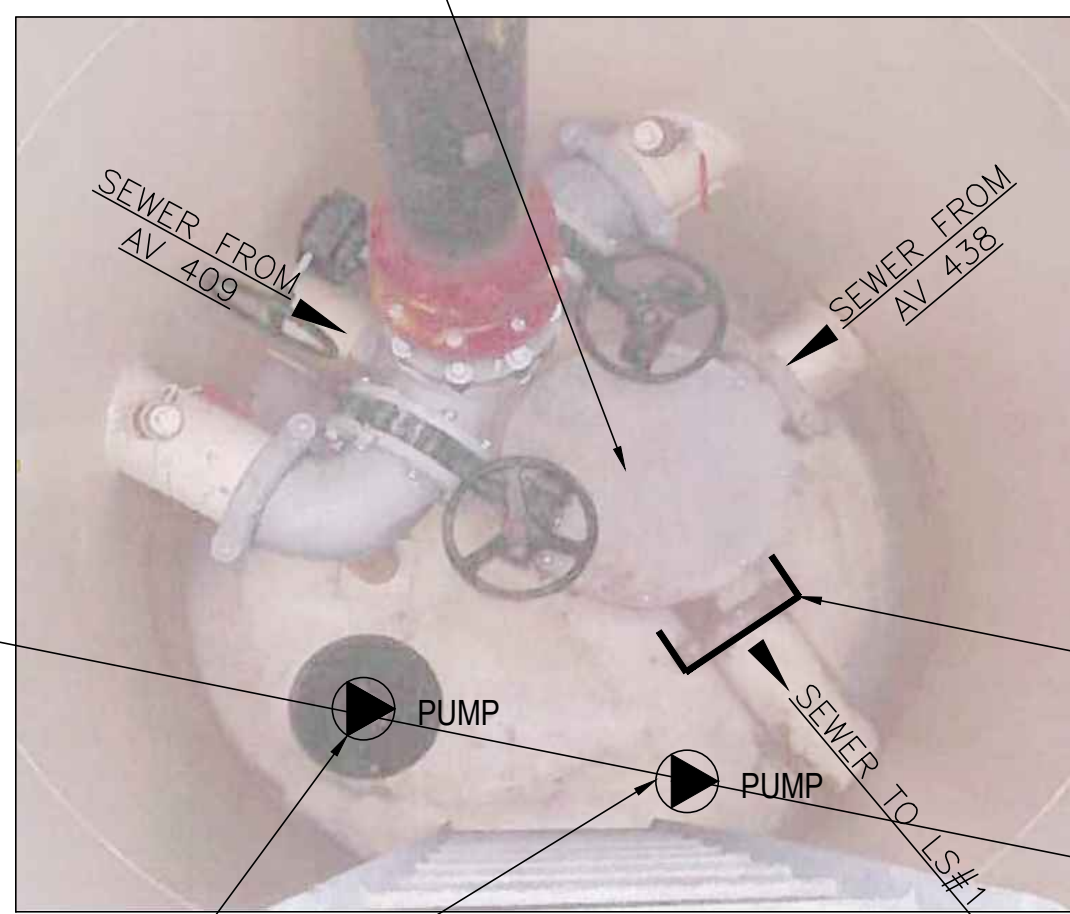


DUTY PUMP TO BE INSTALLED IN AV SUMP

AV 437

BACKUP PUMP TO BE INSTALLED ON AV FLOOR

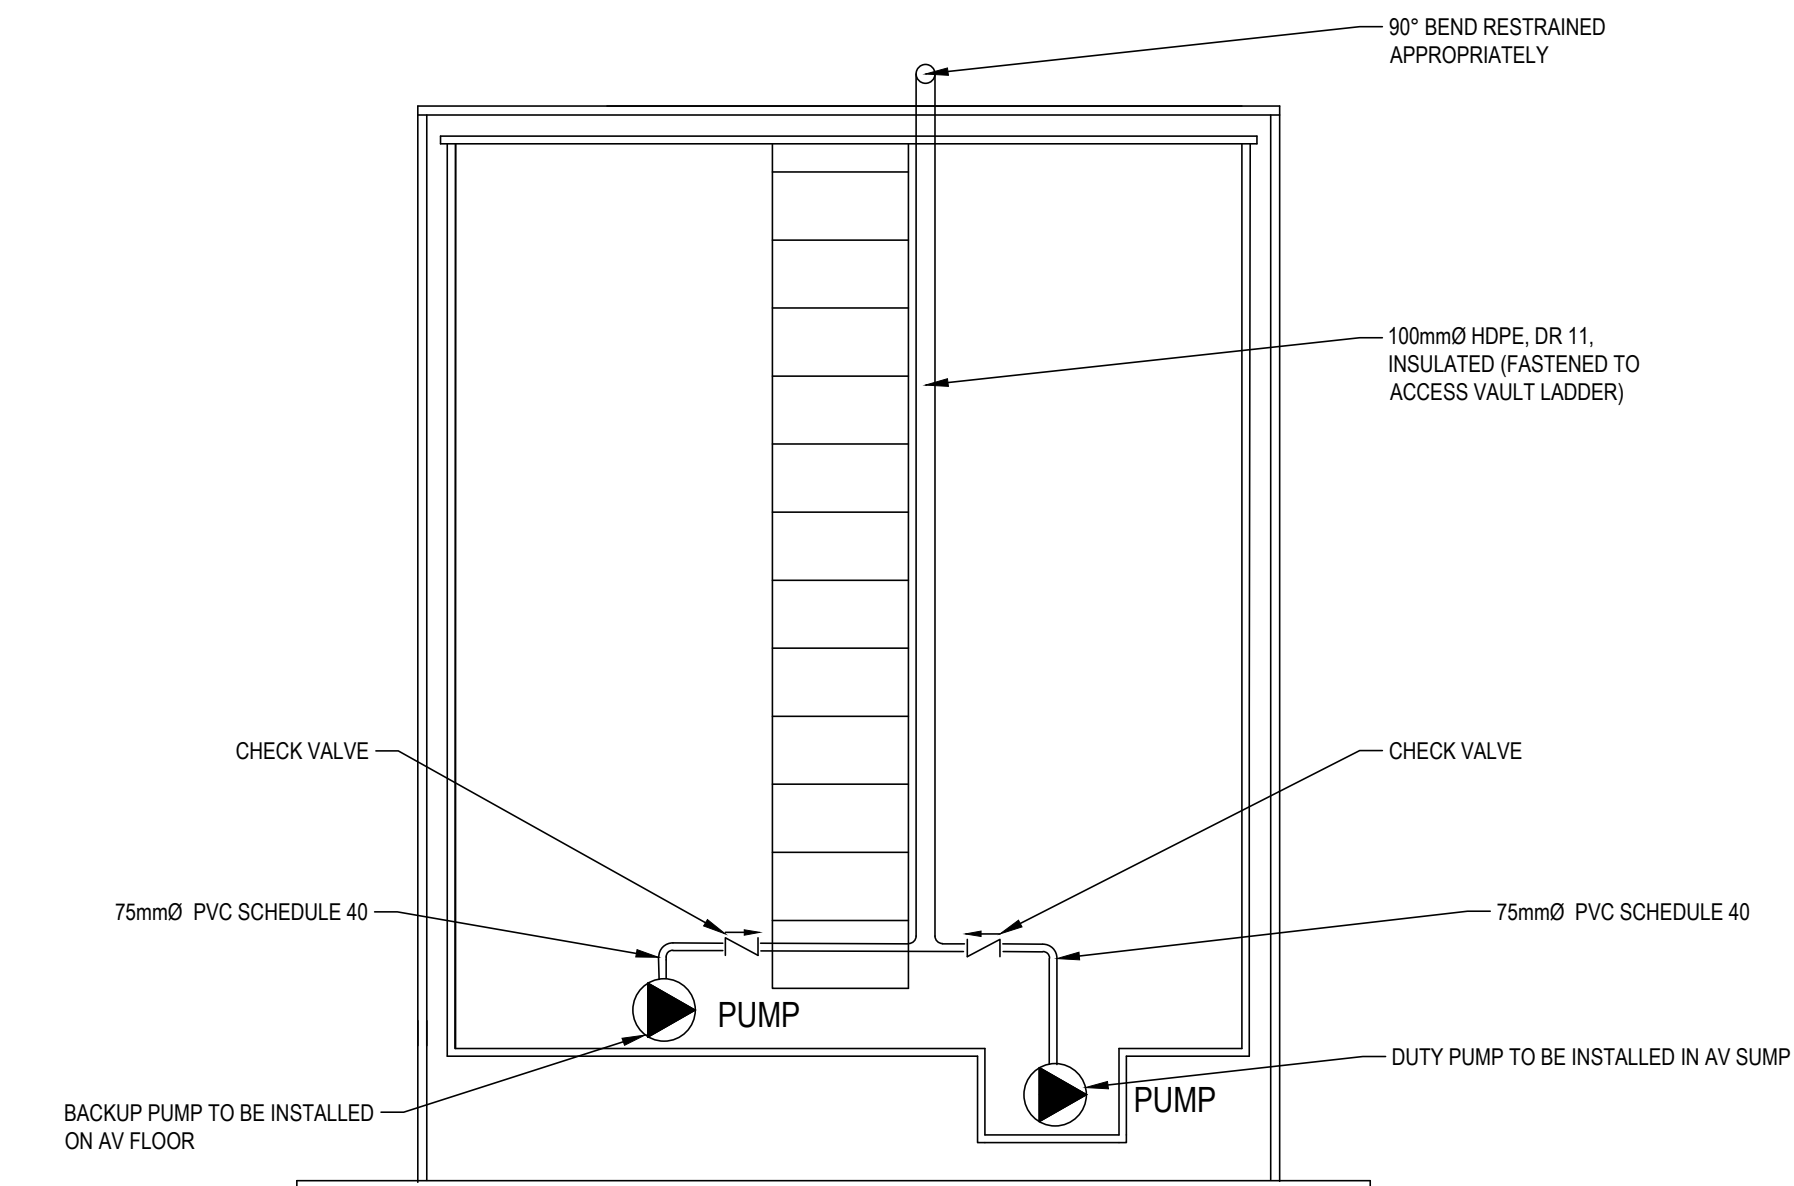


SECTION A-A  
N.T.S.

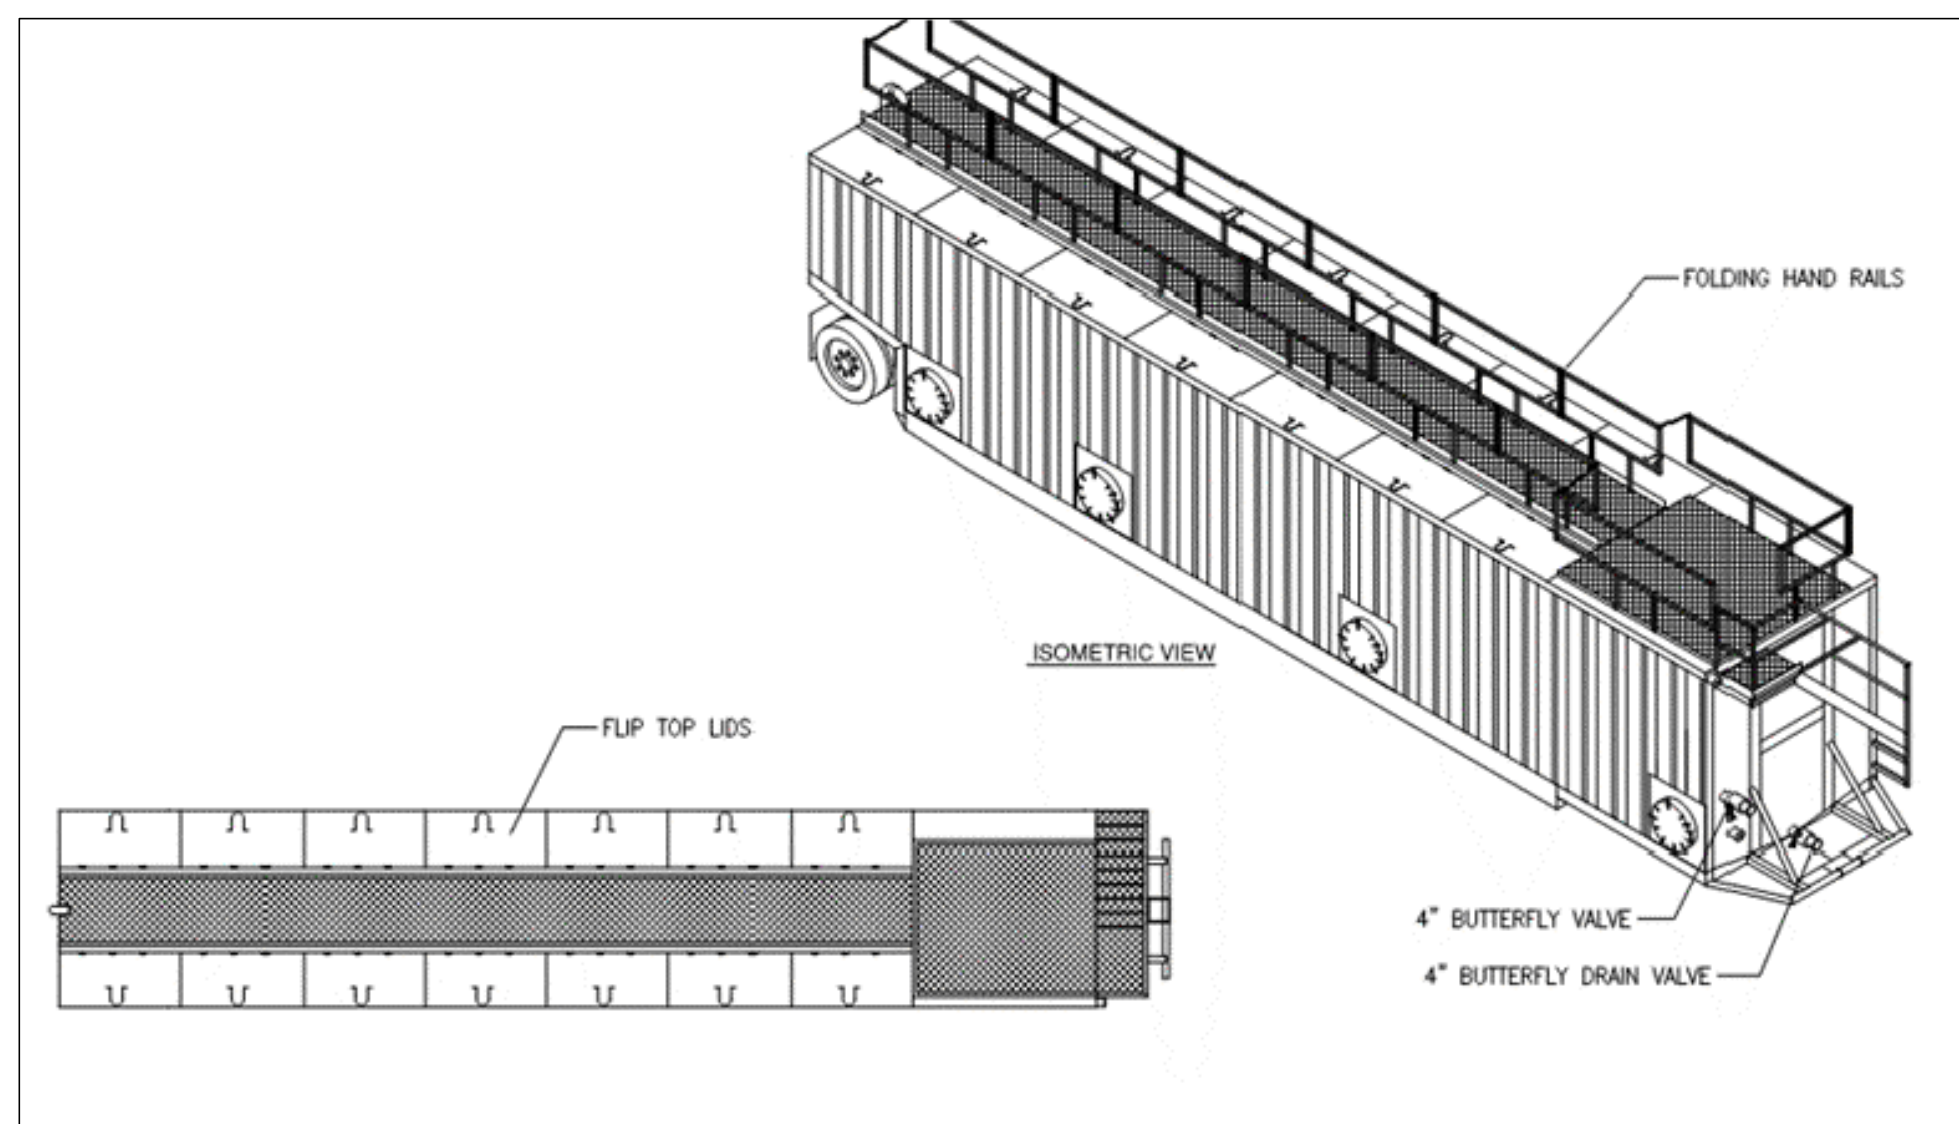

CITY SUPPLIED MOBILE  
TANK FOR REFERENCE  
N.T.S

### LEGEND

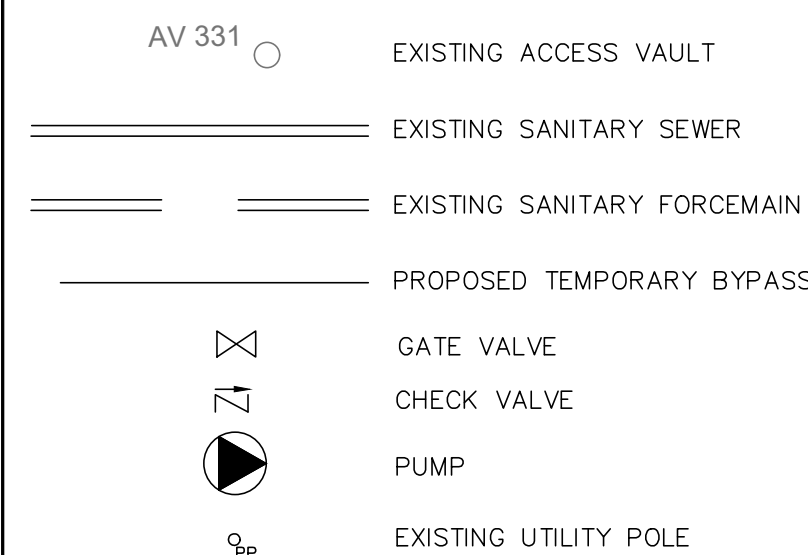

GENERAL NOTES

1. EXACT ALIGNMENT OF TEMPORARY PIPING AND TANKS TO BE DETERMINED IN FIELD.
2. ALL TEMPORARY BENDS TO BE BRACED WITH CONCRETE TRUSS BLOCKS.
3. TEMPORARY FOREMAN PIPING (TANK TO FOREMAN) AND FITTINGS TO BE 200MM HOPE DR 11, INSULATED
4. HYDROSTATIC TEST TEMPORARY HOPE DR FOREMAN PIPING PRIOR TO PUTTING INTO SERVICE.
5. 24 HRS AT 1600 PSI
6. CONTRACTOR TO SUPPLY AND MAINTAIN CONSTRUCTION FENCING AROUND OPEN EXCAVATIONS, ACCESS VAULTS AND MANHOLES.
7. CONTRACTOR TO SUPPLY AND MAINTAIN ALL REQUIRED CONSTRUCTION SIGNAGE
8. TEMPORARY SEWAGE BYPASS SYSTEM
  - 7.1 ALL TEMPORARY HOSES AND POWER CABLES THAT ARE PLACED ALONGSIDE OF THE MANHOLES SHALL BE BELOW SURFACE AND ADEQUATELY SUPPORTED AND PROTECTED. THE INSTALLATION AND OPERATION OF THE TEMPORARY SEWAGE BYPASS SYSTEM SHALL BE PERFORMED TO MINIMIZE DISRUPTIONS TO THE ADJACENT PRIVATE PROPERTY IS DAMAGE, THE CONTRACTOR SHALL REINSTATE THE PROPERTY TO THE SATISFACTION OF THE ENGINEER AND THE PROPERTY OWNER.
  - 7.2 THE CONTRACTOR SHALL BE RESPONSIBLE FOR MONITORING OF TEMPORARY SANITARY BYPASS SYSTEM AND BE ABLE TO RESPOND TO OPERATIONAL ISSUES AS REQUIRED TO PROVIDE AND MAINTAIN CONTINUOUS SANITARY BYPASS PUMPING SYSTEM
  - 7.3 INSTALLATION OF TEMPORARY (AND PERMANENT) CONNECTIONS TO EXISTING 200MM FOREMAN CAN BE COMPLETED DURING THE NIGHT. LS #1 CAN BE TAKEN OFF TO COMPLETION OF THE CITY VACUUM TRUCKS WILL, MANAGE INCOMING FLOWS.

# AS-BUILT DRAWING

AS-BUILT DRAWING INFORMATION PROVIDED BY  
NUNAVUT EXCAVATING LTD. TO EXP SERVICES INC.  
NO FIELD VERIFICATION WAS EXECUTED BY EXP.

1	ISSUED FOR TENDER	8-17-2021
0	ISSUED FOR REVIEW	7-28-2021
No.	Revision	Date

**AS-BUILT**

Professional Seal(s)

Drawn By:

ARL

Dwg Standards Ckd By

Designed By:

Design Checked By:

Scale:

Project Title

AS SHOWN

Project Title

## LIFT STATION #1 BYPASS

Dwg. Title

## TEMPORARY LIFT STATION SITE PLAN

Project No.

FRN-21005203-A0



Dwg. No.

**46-2**

Rev. No.

C




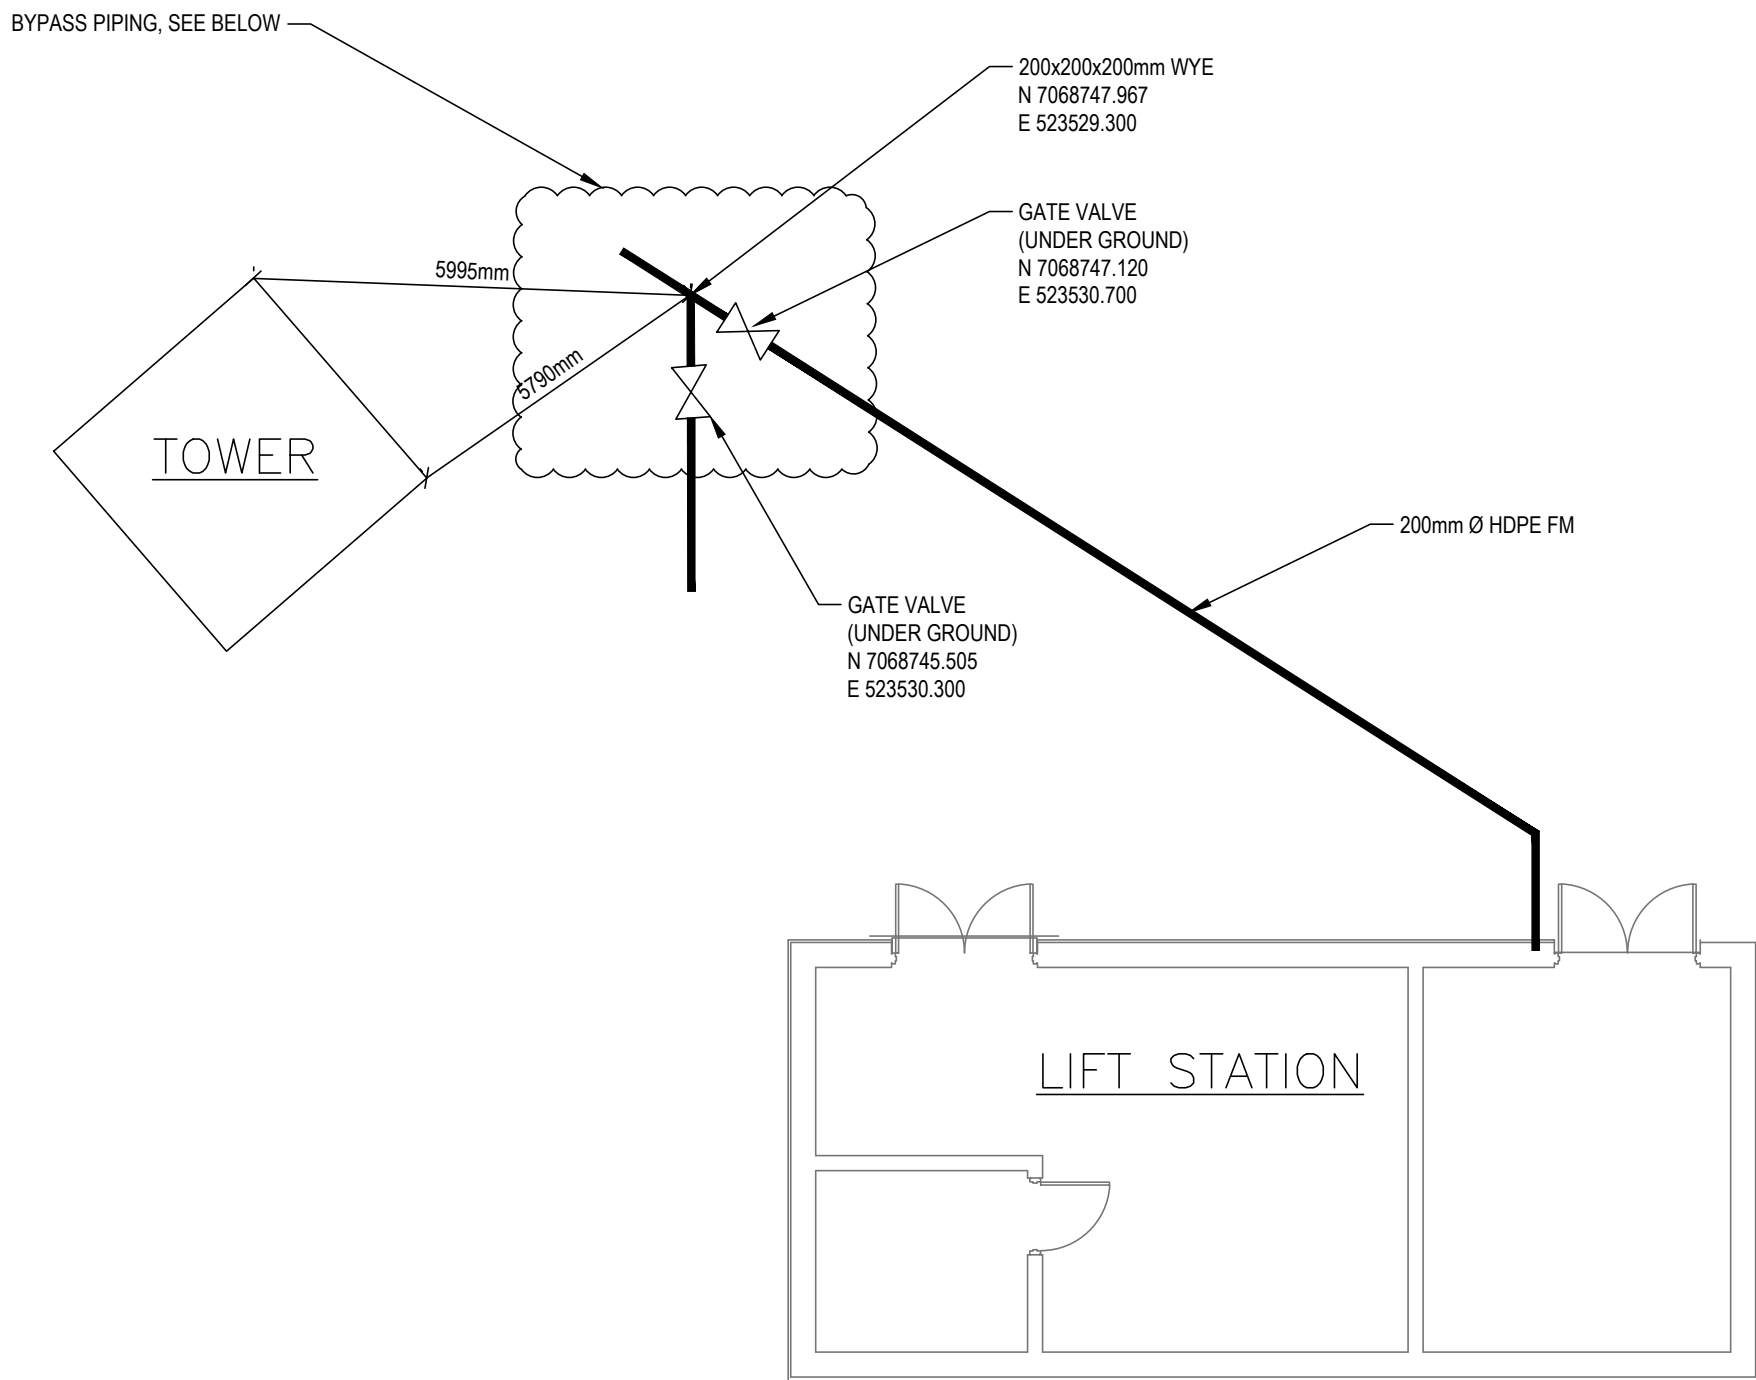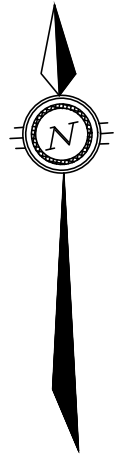



PLAN

BYPASS LINE CONNECTION FOR FUTURE REFERENCE

1:100

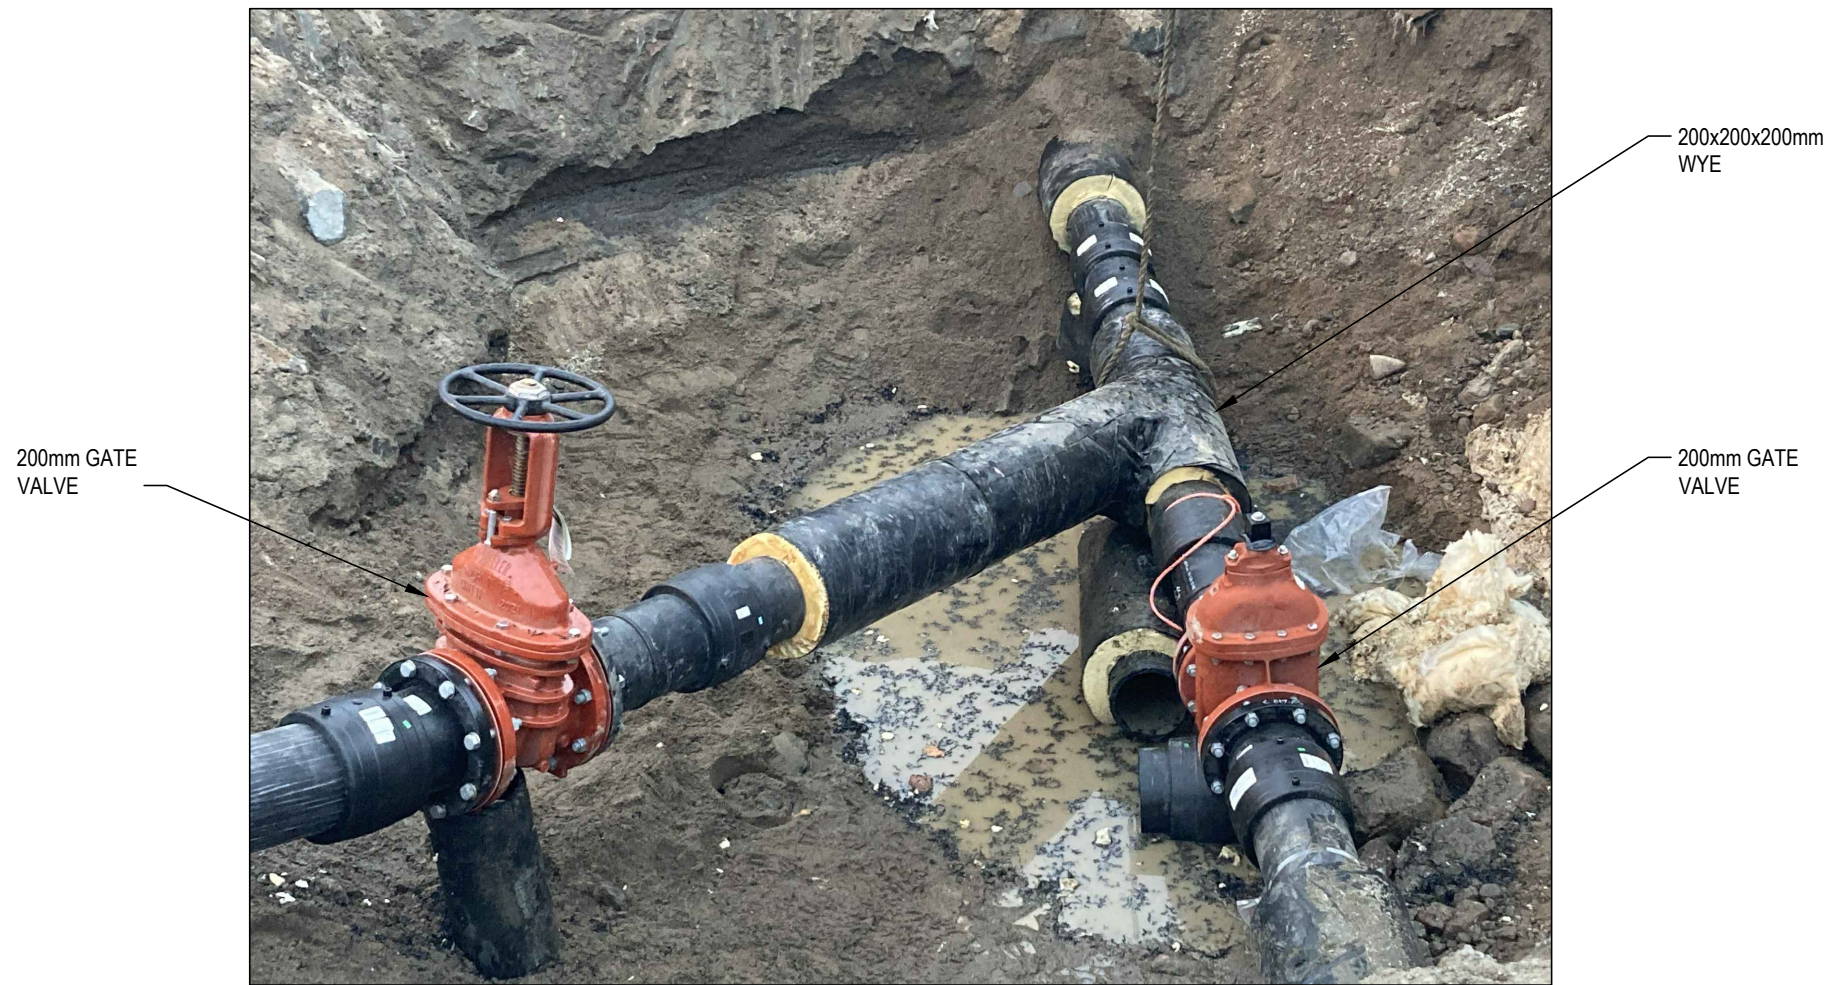

BYPASS PIPING

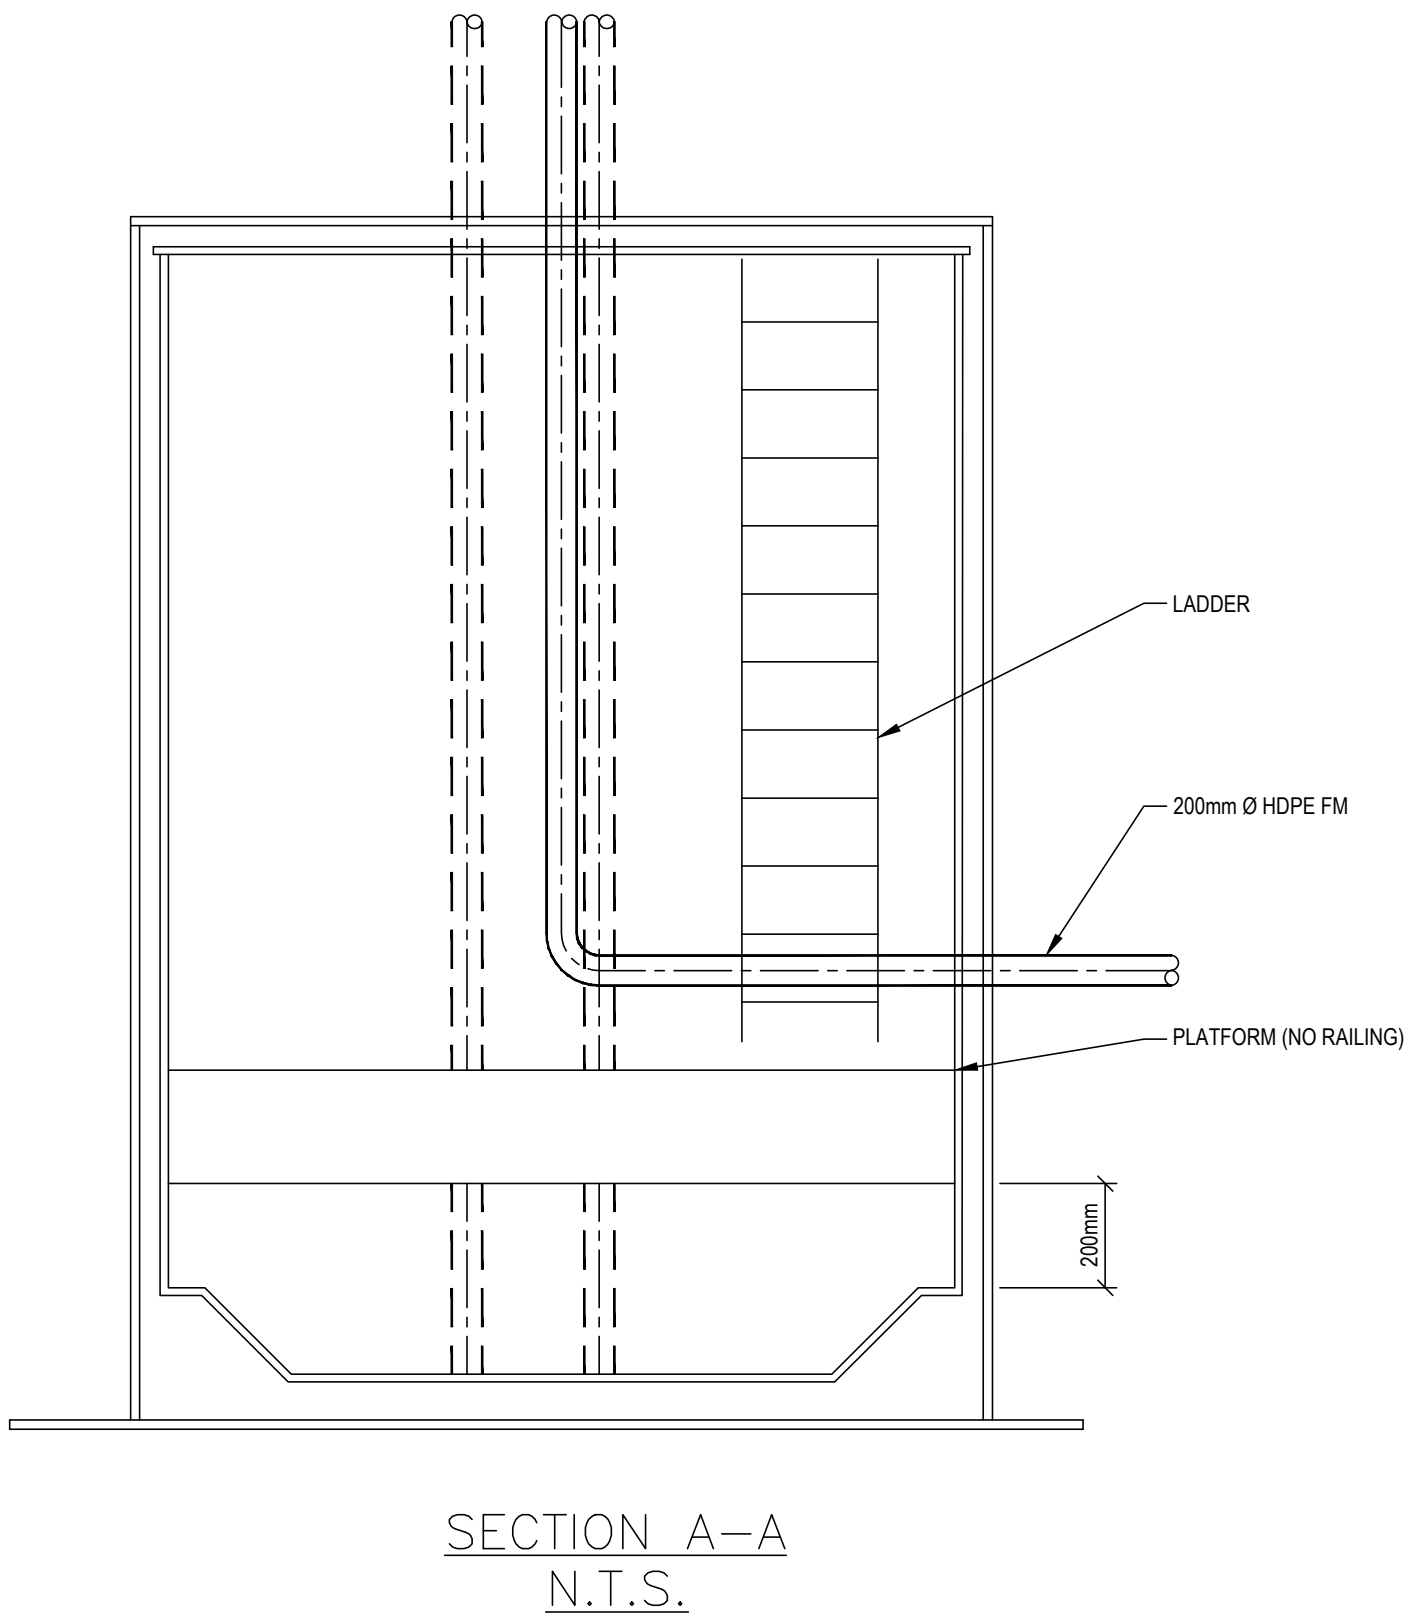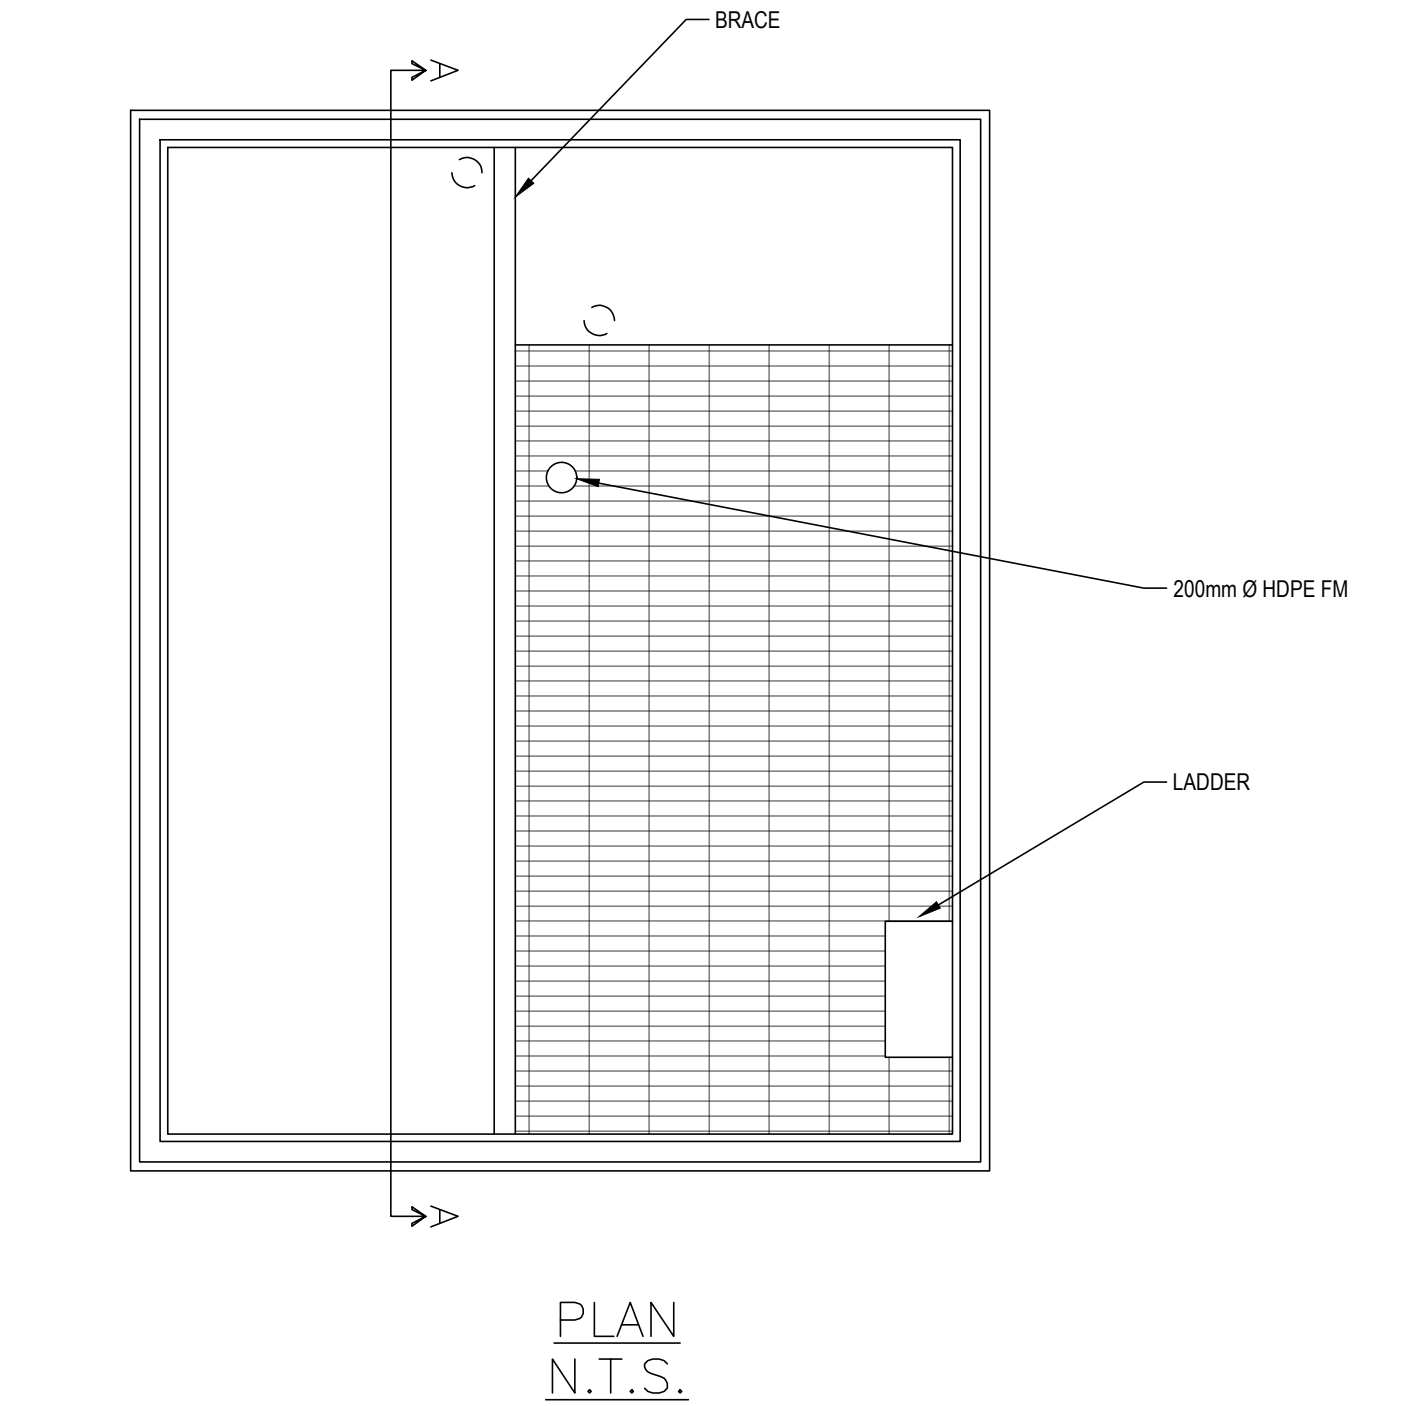

LIFT STATION FLOOR PLAN  
MODIFICATIONS

No.	Issue	Date
A	AS BUILT	2023.JAN.31

## AS-BUILT DRAWING

AS-BUILT DRAWING INFORMATION PROVIDED BY  
NUNAVUT EXCAVATING LTD. TO EXP SERVICES INC.  
NO FIELD VERIFICATION WAS EXECUTED BY EXP.

No.	Revision	Date
-----	----------	------

### AS-BUILT

Professional Seal(s)	

Drawn By: DRAWN

Dwg Standards Ckd By:

Designed By: DESIGNER

Design Checked By:

Scale: AS SHOWN

Project Title

## LIFT STATION #1 BYPASS

### BYPASS CONNECTION AND LIFT STATION MODIFICATION DETAILS

Project No. FRN-21005203-A0

Dwg. No.	Rev. No.
46-2A	A



- NOTES:**
- ALL CONNECTION IN THE SUCTION LINE OF THE PUMPS ARE TO BE SEALED WITH PIPE DOPE. FOLLOW THE SEALANT MANUFACTURER'S RECOMMENDATIONS WHEN SELECTING AND APPLYING THE PIPE DOPE. THE PIPE DOPE SHOULD BE COMPATIBLE WITH THE LIQUID BEING PUMPED.
  - PUMPS MUST BE SUPPORTED OR SHIMMED TO PROVIDE FOR LEVEL OPERATION OR TO ELIMINATE VIBRATION.

**KEYNOTES:**

- 1

INSTALL OWNER SUPPLIED GORMAN RUPP SUPER T SERIES PUMP AND MOTOR, MODEL T6A3S-B1F C/W BASEPLATE AND AUTOMATIC AIR RELEASE VALVE.
- 2

PUMP SUCTION.
- 3

HORIZONTAL AIR RELEASE VALVE ASSEMBLY. VALVE SUPPLIED BY OWNER AND INSTALLED BY CONTRACTOR. PIPING SUPPLIED AND INSTALLED BY CONTRACTOR.
- 4

150 Ø SWING CHECK VALVE C/W SLOW CLOSING.
- 5

150 Ø 90° LR ELBOW, SS.
- 6

PRESSURE GAUGE ASSEMBLY.
- 7

150 Ø PLUG VALVE.
- 8

200 Ø X 150 Ø CONCENTRIC REDUCER, SS.
- 9

200 Ø X 150 Ø REDUCING TEE, SS.
- 10

200 Ø 90° LR ELBOW, SS.
- 11

SEWAGE AIR RELIEF VALVE.
- 12

200 Ø BLIND FLANGE.
- 13

200 Ø TEE, SS.
- 14


DISCHARGE CONNECTION.
- 15

STEEL I-BEAM PUMP SKID BY CONTRACTOR.
- 16

200 Ø FLANGE x CAMLOCK ADAPTOR.
- 17

SUCTION CONNECTION.
- 18

ADJUST PUMP HEIGHT ACCORDINGLY TO RETAIN 265mm ± CLEARANCE FROM TOP OF SKID TO CENTERLINE OF SUCTION.

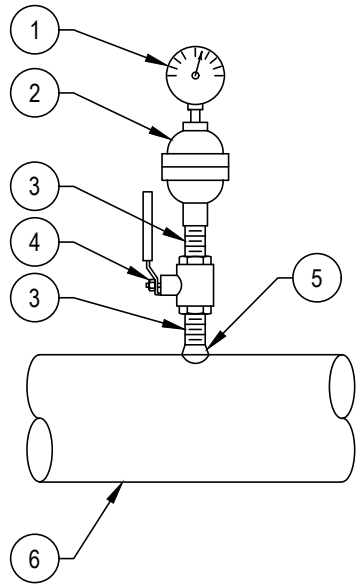

**KEYNOTES:**

- 1

PRESSURE GAUGE.
- 2

GAUGE ISOLATOR/DIAPHRAGM SEAL.
- 3

THREADED NIPPLE, SIZE AS REQUIRED.
- 4

13mm Ø BALL VALVE.
- 5

13mm Ø FNPT THREAD-O-LET.
- 6

CARRIER PIPE.

TYPICAL DETAIL

PRESSURE GAUGE

NOT TO SCALE

**KEYNOTES:**

- 1

STANDON MODEL C92 SADDLE CLAMP ASSEMBLY TO SUIT PIPE O.D. (C/W LINER FOR IPS-OD PVC PIPE AS APPLICABLE).
- 2

SCH 40 OR BETTER GALVANIZED STEEL EXTENSION PIPE OF DIAMETER TO SUIT CUPS AND OF LENGTH TO SUIT PIPE ALIGNMENT (SEE TABLE FOR EXTENSION PIPE SIZE REQUIRED).
- 3

CLEAN AND TOUCH UP WELD WITH COLD GALVANIZING PRIMER AND PAINT TO ASTM A780.
- 4

SHIMS AS REQUIRED TO SET ASSEMBLY LEVEL AND PLUMB.
- 5

GALVANIZED OR BETTER NUTS, WASHER AND STUDS TO SUIT.
- 6

HEIGHT VARIES.
- 7

PIPE DIAMETER AND MATERIAL VARIES.
- 8

BASE PLATES TO CONFORM TO STANDON'S REQUIREMENTS FOR SUPPORTED PIPE SIZE.
- 11

STANDON MODEL S89 FLANGE SUPPORT ASSEMBLY TO SUIT PIPE FLANGE DRILLING CONFORMING TO ANSI B16.1 CLASS 125/150.

SUPPORTED PIPE DIA.	BASE PLATE SIZE	EXTENSION PIPE SIZE	MIN. CLEARANCE
50 TO 75	100 x 150	50 SCH 40	180mm
100 TO 300	200 x 200	50 SCH 40	180mm
350 TO 400	200 x 200	75 SCH 40	240mm
450 TO 600	300 x 300	100 SCH 40	250mm
750 TO 900	380 x 380	150 SCH 40	250mm

**NOTE:**


FOR ANY SUPPORT W/ CLEARANCE TO FLOOR MORE THAN 1830mm USE 100mm OR LARGER SCH 40. NOT ALL SUPPORTS APPLY.

SUPPORTED PIPE DIA.	BASE PLATE SIZE	EXTENSION PIPE SIZE	MIN. CLEARANCE
50 TO 300	100 x 150	50 SCH 40	180mm
350 TO 400	200 x 200	75 SCH 40	240mm
450 TO 600	300 x 300	100 SCH 40	250mm


THIS SCHEDULE APPLIES TO FP05 FLAT PLATE SUPPORT, S92M (MODIFIED) SUPPORT, FLANGE CRADLE AND S89 FLANGE SUPPORT ONLY.

**NOTE:**

FOR ANY SUPPORT W/ CLEARANCE TO FLOOR MORE THAN 1830mm USE 100mm OR LARGER SCH 40.

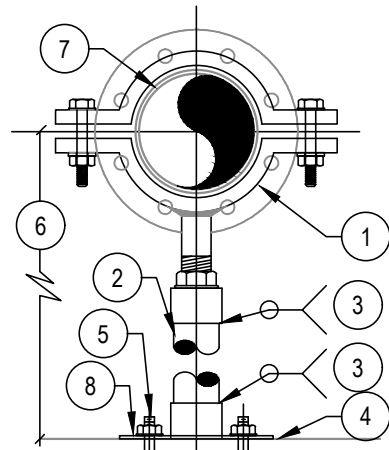

C92

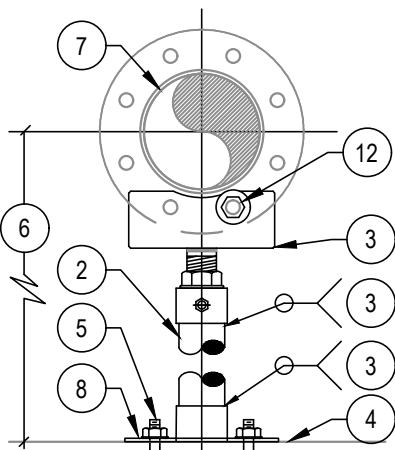


S89

TYPICAL DETAIL

ADJUSTABLE FLOOR MOUNTED PIPE SUPPORTS

NOT TO SCALE

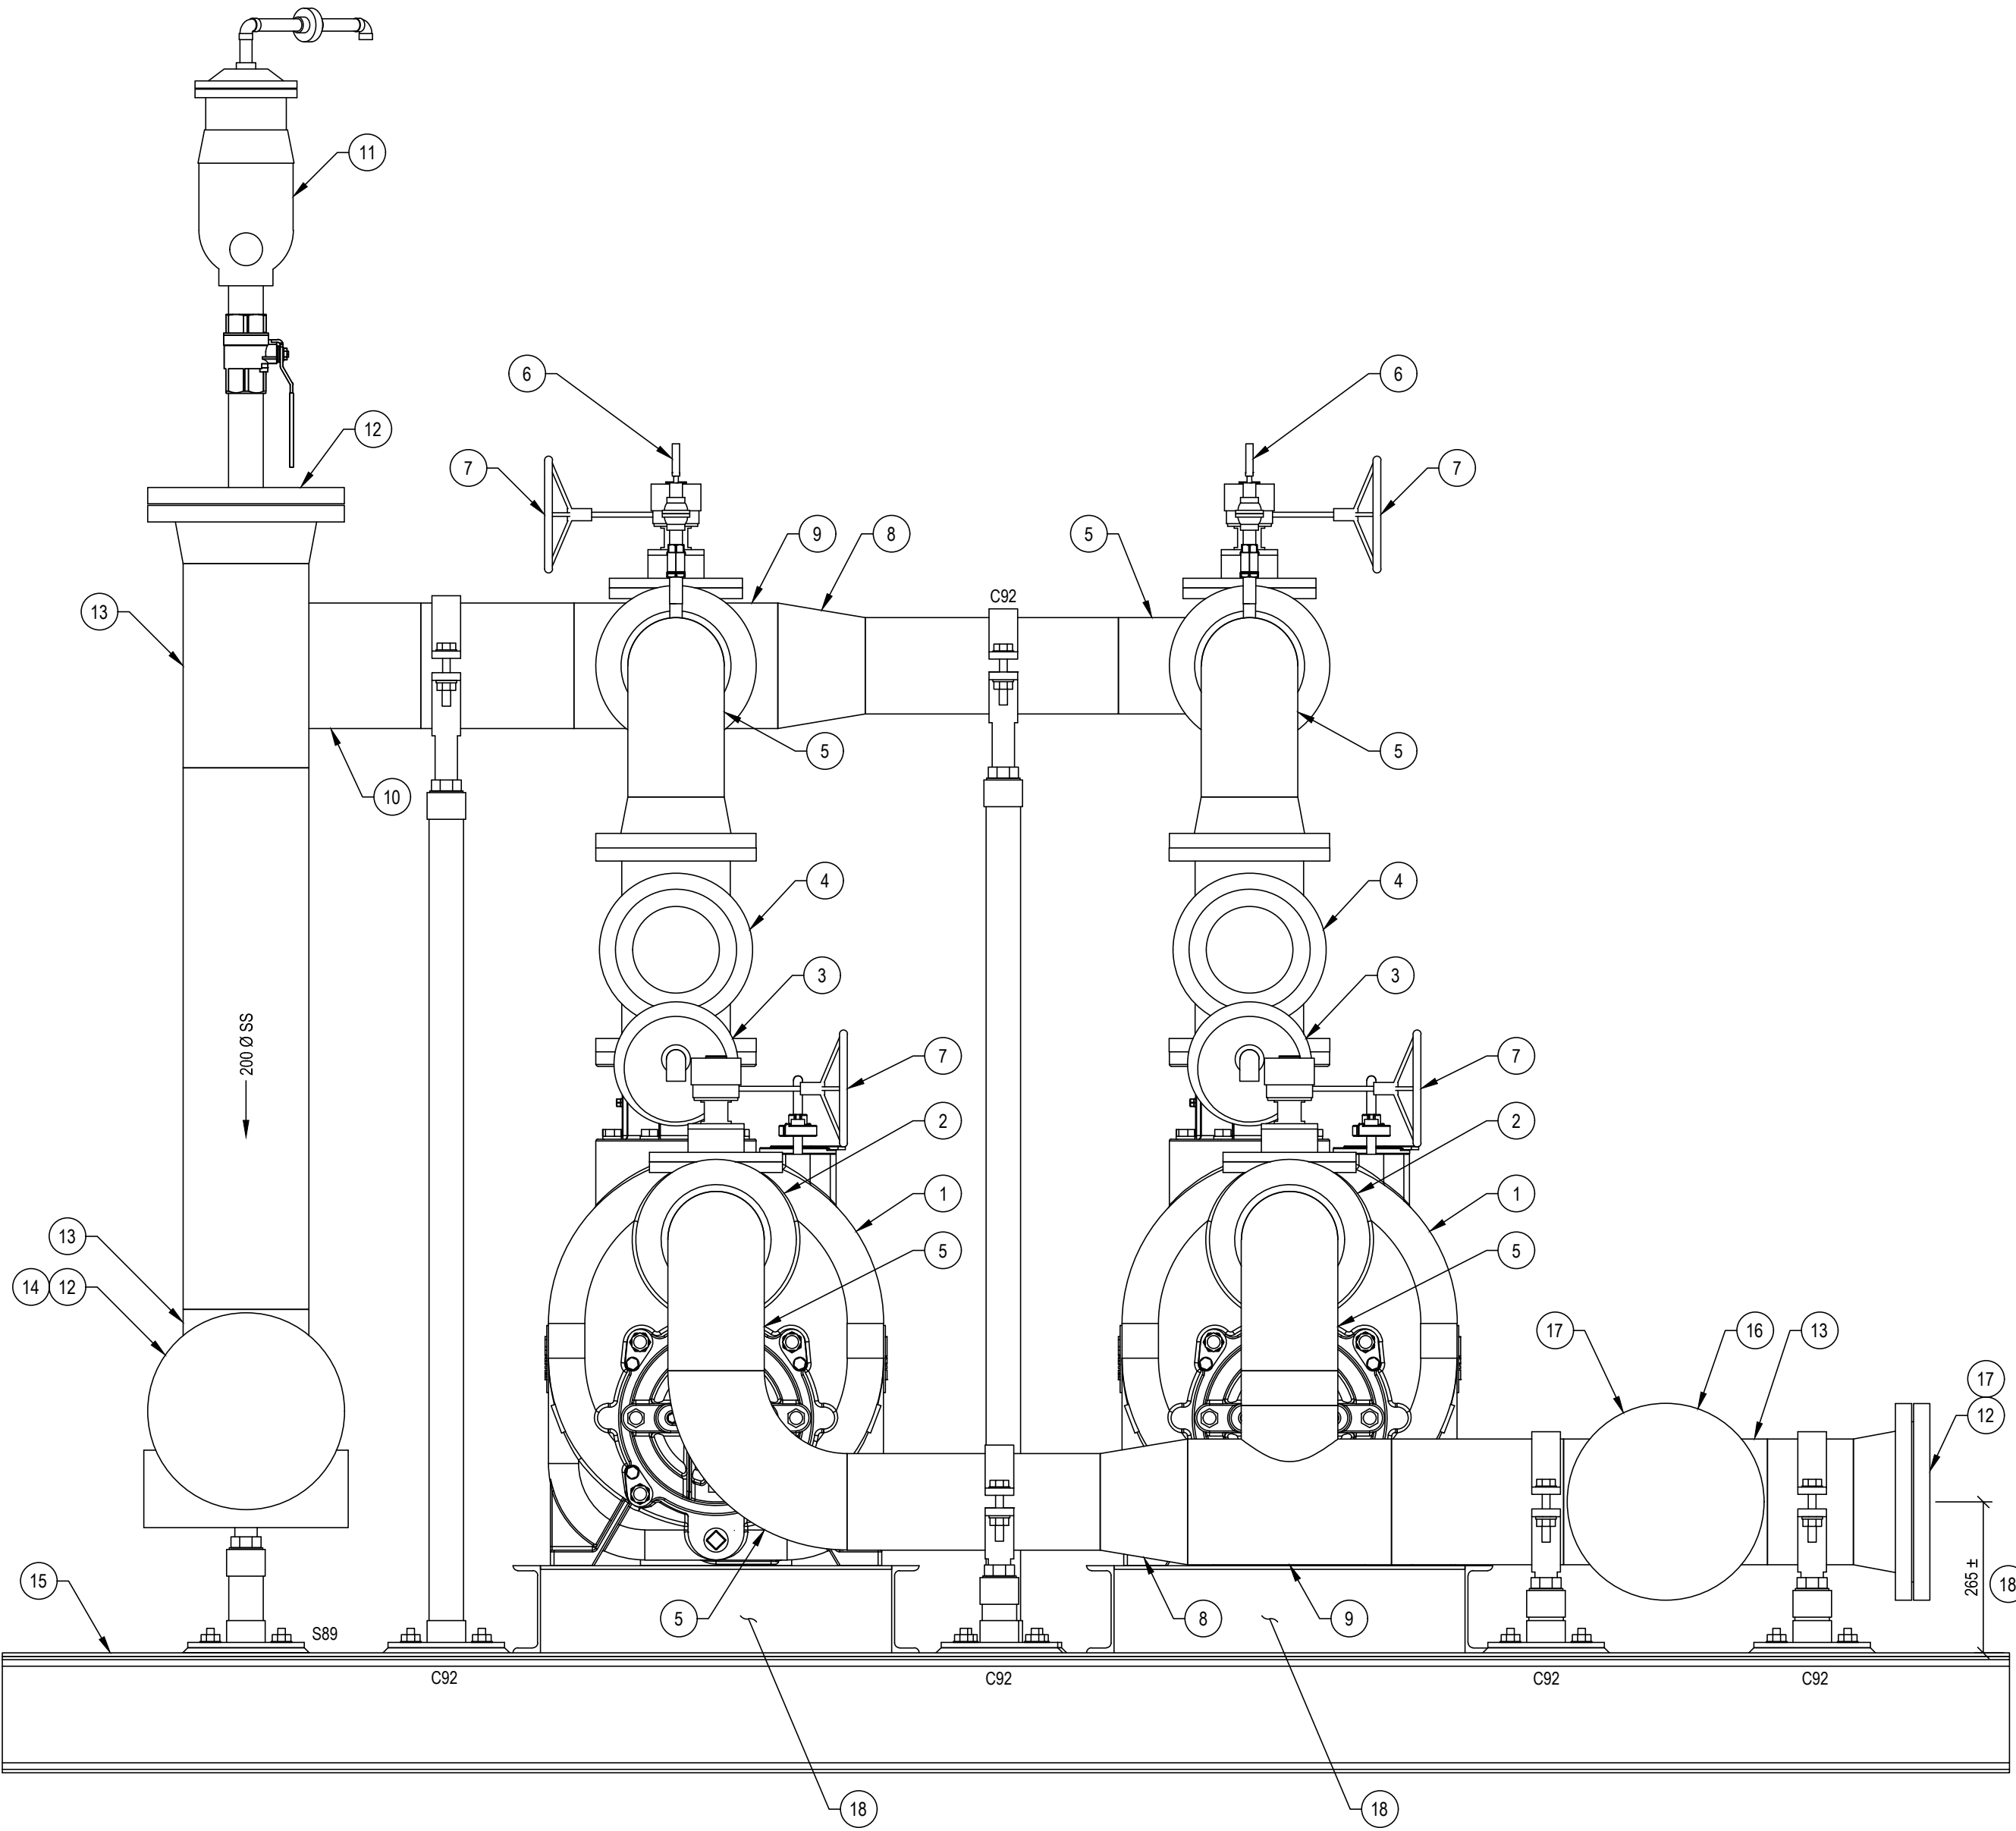

A

SECTION

TEMPORARY LIFT STATION

1:10

1:10

EXP Services Inc.  
T: +1 506.452.9000 F: +1 506.459.3954  
1133 Regent Street, Suite 300  
Fredericton, NB, E3B 3Z2  
CANADA  
[www.exp.com](http://www.exp.com)



• BUILDINGS • EARTH & ENVIRONMENT • ENERGY •  
• INDUSTRIAL • INFRASTRUCTURE • SUSTAINABILITY •

CAUTION: DO NOT SCALE DRAWINGS.  
THIS REPRODUCTION MAY BE AT A SIZE DIFFERENT THAN ORIGINALLY DRAWN. EXP ASSUMES NO RESPONSIBILITY FOR INCORRECT SCALING. UNAUTHORIZED REPRODUCTION OR REUSE IS STRICTLY PROHIBITED. NOT PUBLISHED - ALL RIGHTS RESERVED. EXP EXPRESSLY DISCLAIMS RESPONSIBILITY ARISING FROM UNAUTHORIZED USE OF THESE DRAWINGS AND NOTES. AUTHORIZATION MUST BE IN WRITING.

© EXP, 2020

No.	Issue	Date
A	ISSUED FOR REVIEW	2021_AUG.13
B	ISSUED FOR TENDER	2021_AUG.30
C	AS BUILT	2023_JAN.31

**AS-BUILT  
DRAWING**

AS-BUILT DRAWING INFORMATION PROVIDED BY  
NUNAVUT EXCAVATING LTD. TO EXP SERVICES INC.  
NO FIELD VERIFICATION WAS EXECUTED BY EXP.

No.	Revision	Date
-----	----------	------

**AS-BUILT**

Professional Seal(s)

Drawn By: ARL

Dwg Standards Ckd By:

Designed By: EAB/JFP

Design Checked By:

Scale: AS SHOWN

Project Title

**LIFT STATION #1 BYPASS**

Dwg. Title

**TEMPORARY LIFT STATION  
PLAN AND SECTION**

Project No. FRN-21005203-A0

Dwg. No. Rev. No.

**46-3**

**C**


\\EXP\DATA\OT\FRN-21005203-A0\60 EXCAVATIONS\REVISED\DESIGN\4. TEMPORARY EQUALIZATION TANK SECTION

ALAN FINLAY

13/1/2023 3:18 PM

A  
4-2

SECTION  
TEMPORARY EQUALIZATION TANK

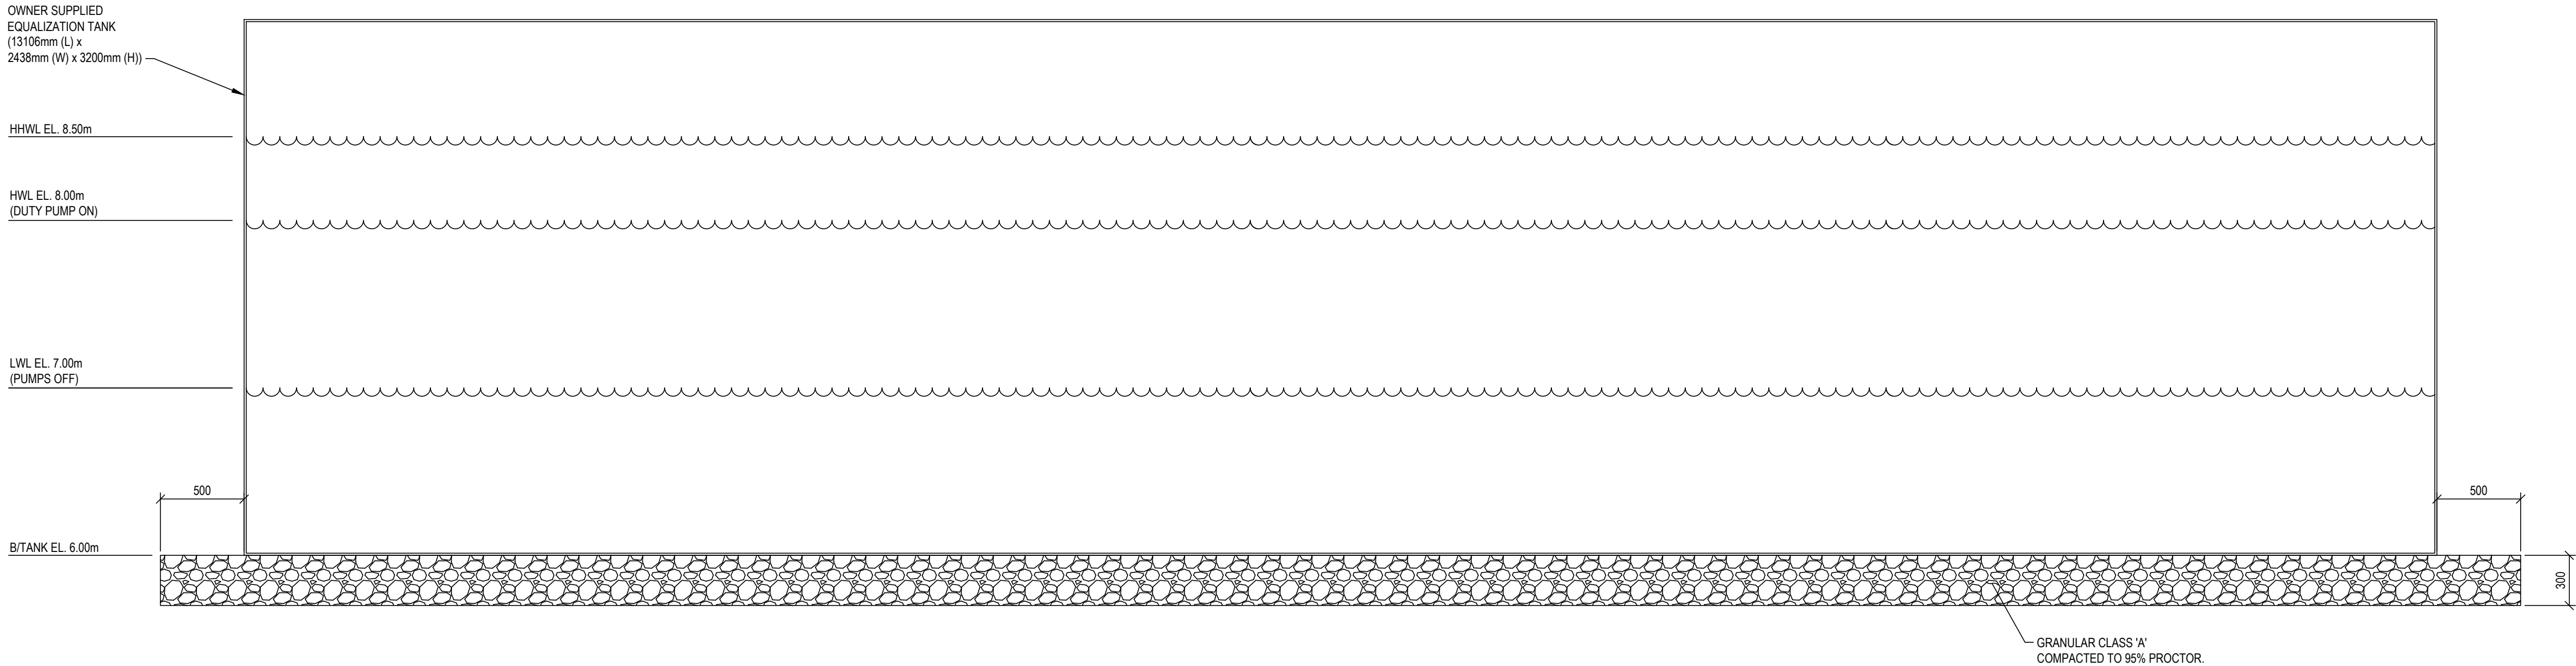

EXP Services Inc.  
T: +1 506.452.9000 | F: +1 506.459.3954  
1133 Regent Street, Suite 300  
Fredericton, NB, E3B 3Z2  
CANADA  
[www.exp.com](http://www.exp.com)



• BUILDINGS • EARTH & ENVIRONMENT • ENERGY •  
• INDUSTRIAL • INFRASTRUCTURE • SUSTAINABILITY •

CAUTION: DO NOT SCALE DRAWINGS.  
THIS REPRODUCTION MAY BE AT A SIZE DIFFERENT THAN ORIGINALLY DRAWN. EXP ASSUMES NO RESPONSIBILITY FOR INCORRECT SCALING. UNAUTHORIZED REPRODUCTION OR REUSE IS STRICTLY PROHIBITED. NOT PUBLISHED - ALL RIGHTS RESERVED. EXP EXPRESSLY DISCLAIMS RESPONSIBILITY ARISING FROM UNAUTHORIZED USE OF THESE DRAWINGS AND NOTES. AUTHORIZATION MUST BE IN WRITING.

© EXP, 2020

No.	Issue	Date
A	ISSUED FOR REVIEW	2021.AUG.13
B	ISSUED FOR TENDER	2021.AUG.30
C	AS BUILT	2023.JAN.31

#### NOTES:

- CONTRACTOR TO SUPPLY AND INSTALL LEVEL REGULATOR FLOAT SUPPORT BRACKET/S/PACERS MOUNTED TO TANK AS REQUIRED, OR AS DIRECTED BY ENGINEER.
- ANY DAMAGED COATING IS TO BE TOUCHED UP WITH EPOXY COATING. FOLLOW MANUFACTURERS RECOMMENDATIONS WHEN APPLYING.

AS-BUILT  
DRAWING

AS-BUILT DRAWING INFORMATION PROVIDED BY  
NUNAVUT EXCAVATING LTD. TO EXP SERVICES INC.  
NO FIELD VERIFICATION WAS EXECUTED BY EXP.


No.	Revision	Date
-----	----------	------

AS-BUILT

Professional Seal(s)

Drawn By: ARL

Dwg Standards Ckd By:

Designed By: EAB/JFP

Design Checked By:

Scale: AS SHOWN

Project Title

LIFT STATION #1 BYPASS

Dwg. Title

TEMPORARY  
EQUALIZATION TANK  
SECTION

Project No. FRN-21005203-A0

Dwg. No. Rev. No.

46-4


C

1:25

\\EPDATA\AUT\TFN\21005203-A0\REV\DRAWINGS\FIRE DESIGNS\6-1 TEMPORARY LIFT STATION ELECTRICAL SITE PLAN

ALAN FINLAY

15/1/2023 3:29 PM

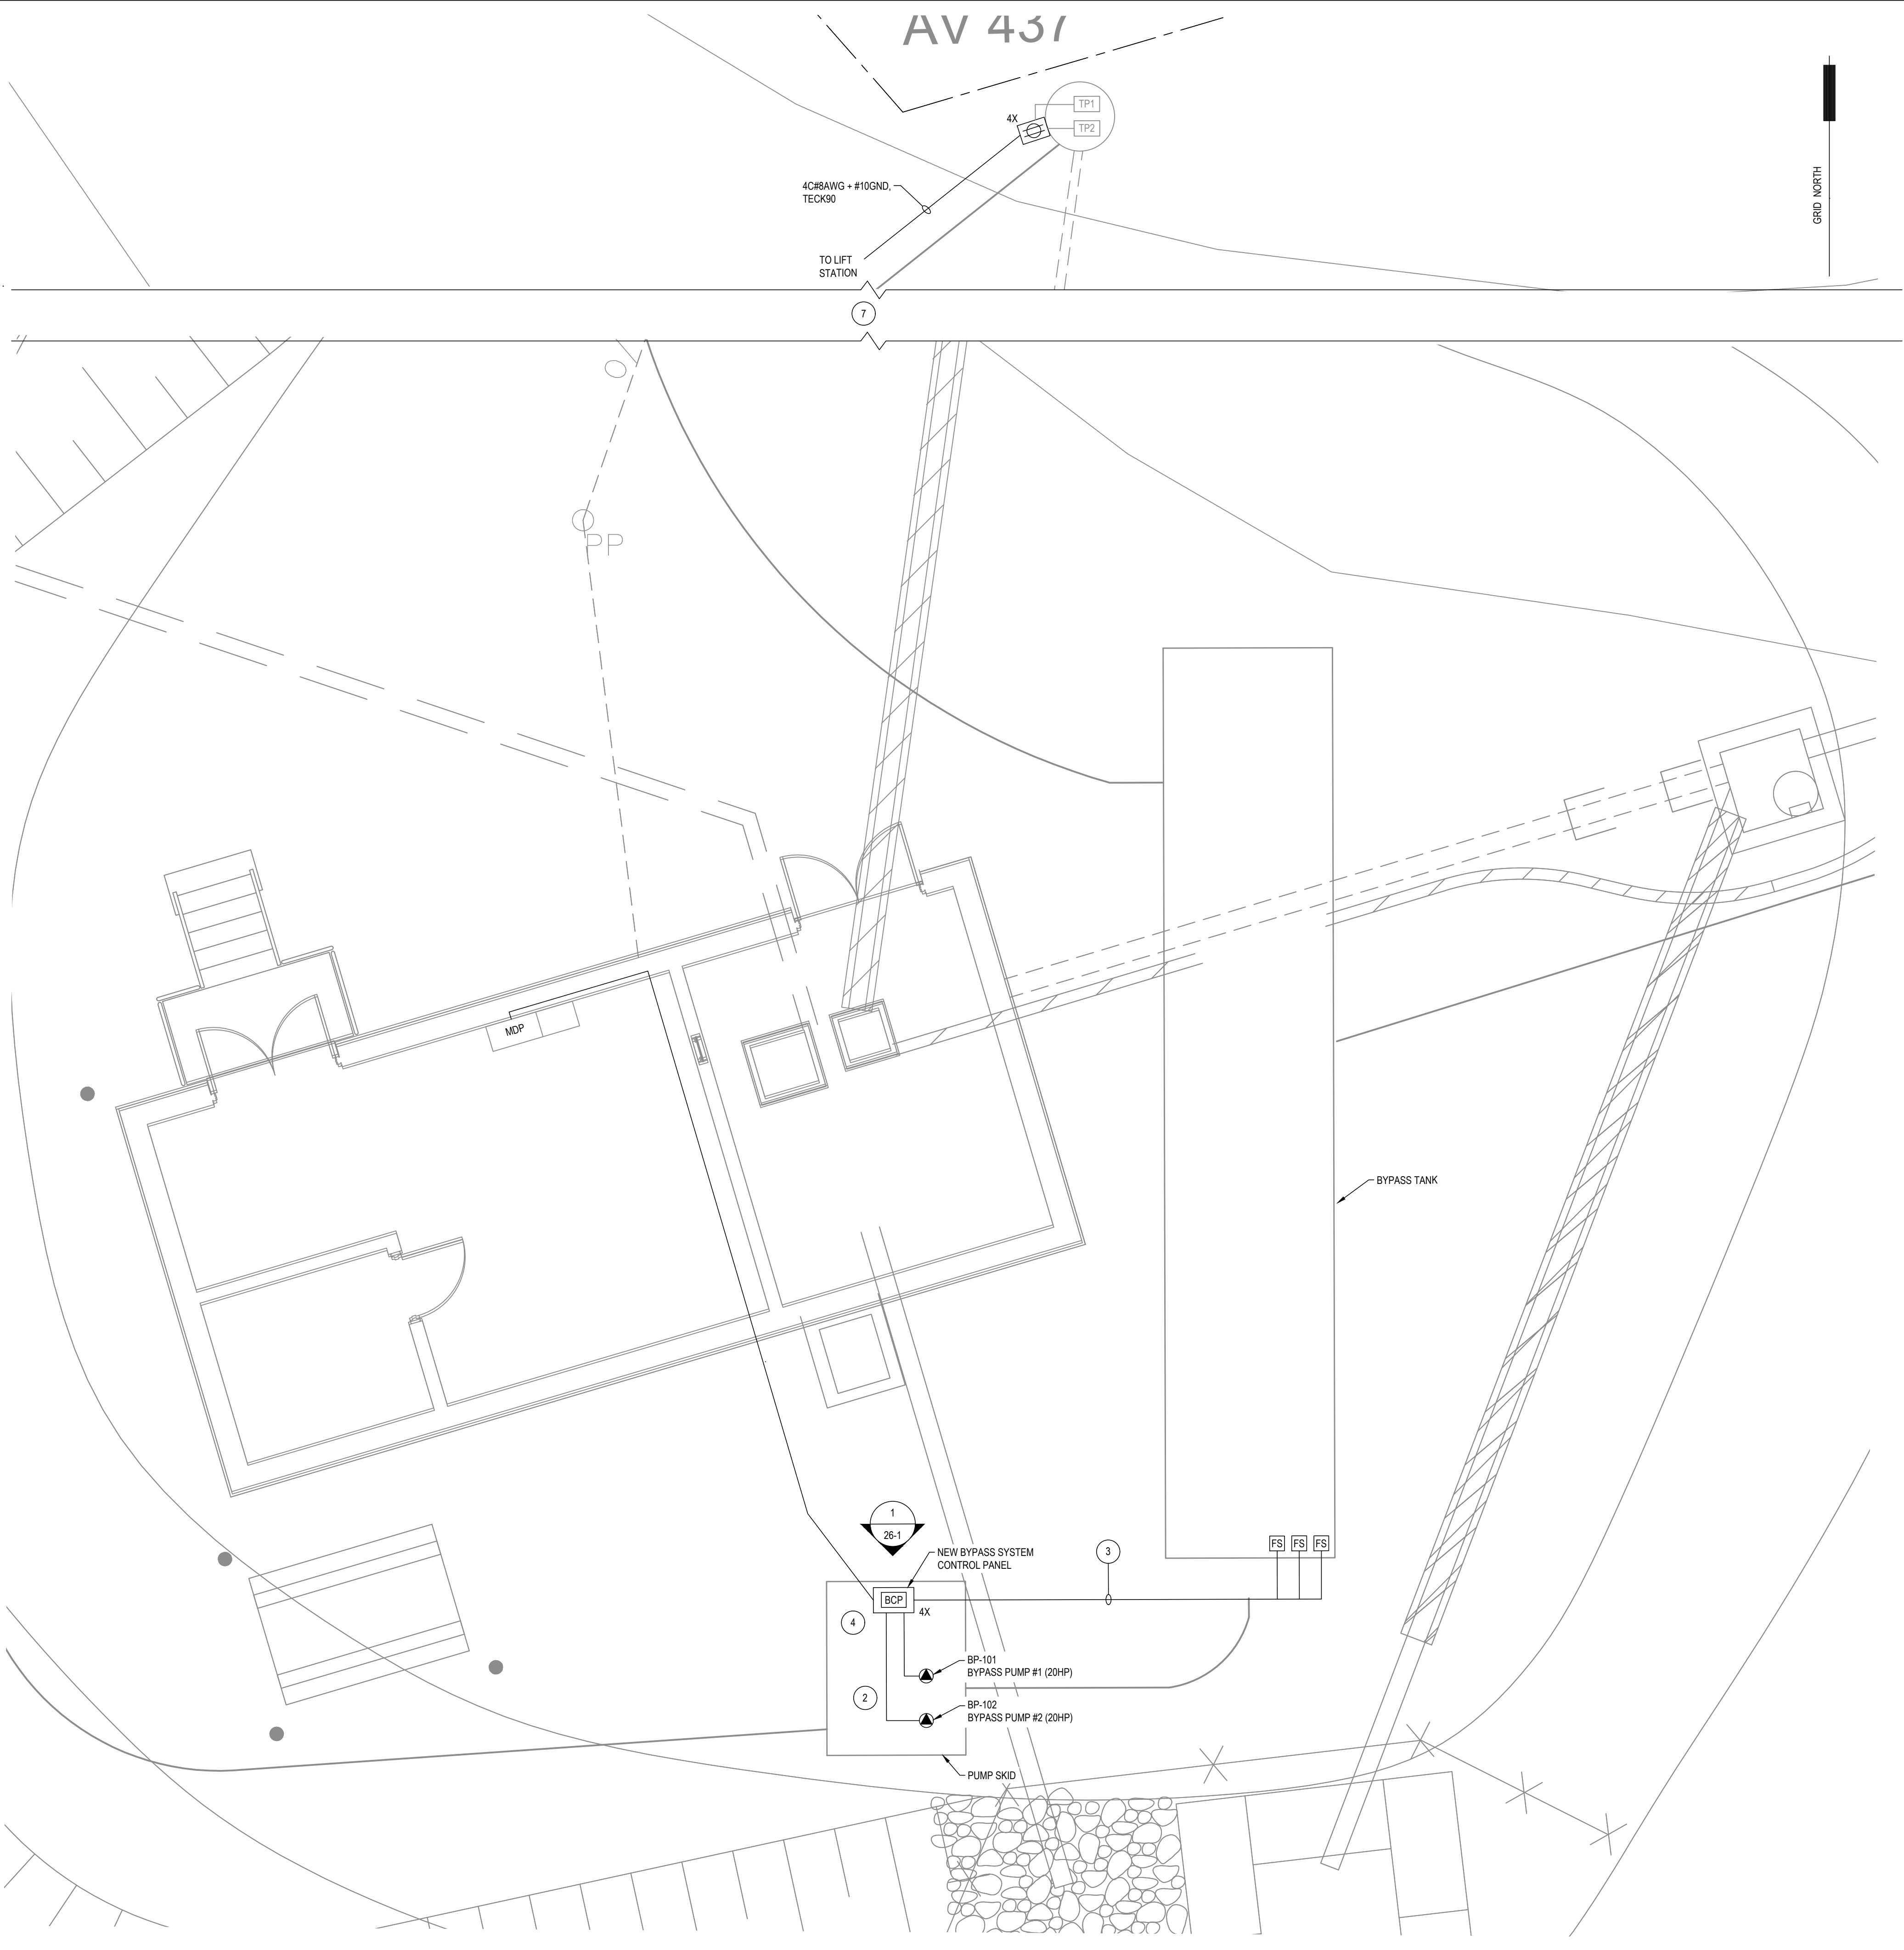

AV 431

4C#8AWG + #10GND,  
TECK90

TO LIFT  
STATION

7

4X

TP1

TP2

GRID NORTH

MDP

← BYPASS TANK

1

26-1

NEW BYPASS SYSTEM  
CONTROL PANEL

4

BP-101

← BYPASS PUMP #1 (20HP)

2

BP-102

← BYPASS PUMP #2 (20HP)

← PUMP SKID



3

FS

FS

FS

SITE PLAN

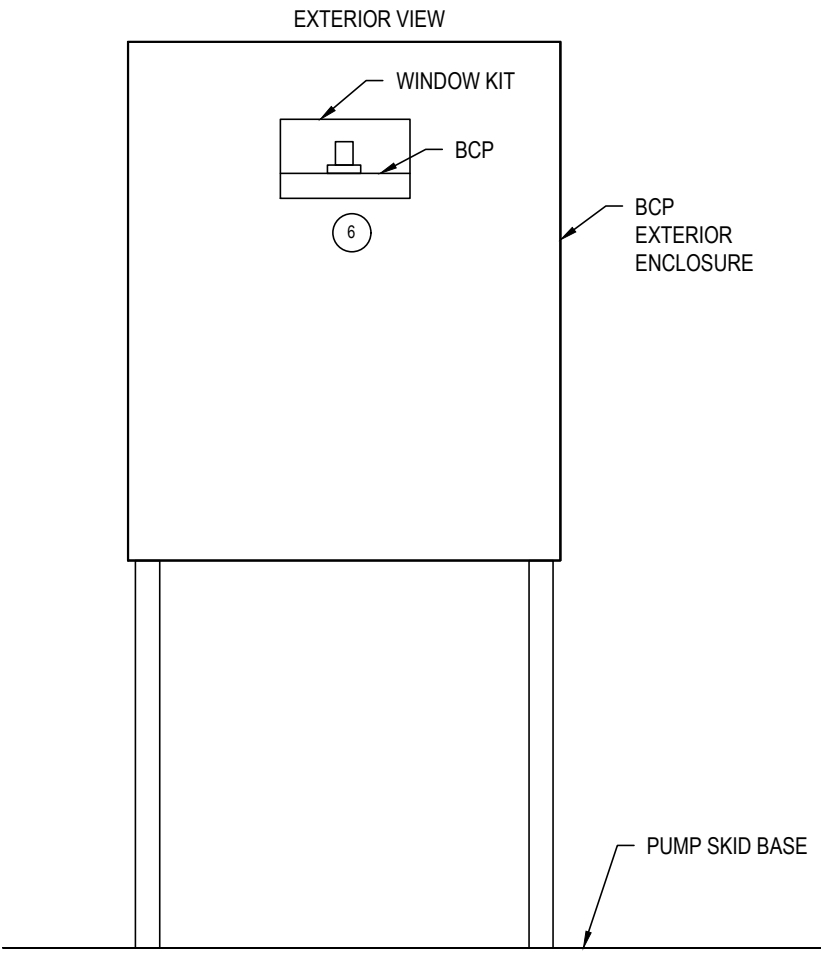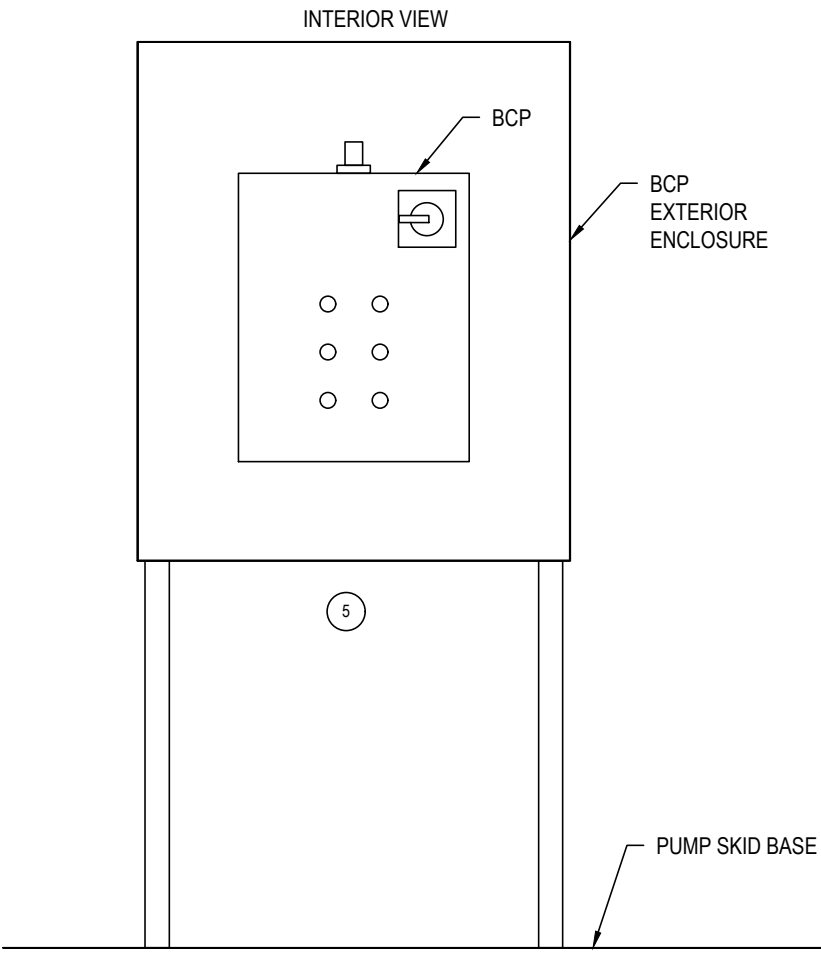

1

ELEVATION

BYPASS PUMP CONTROL PANEL

NOT TO SCALE

LEGEND:

- DIRECT CONNECTION AS INDICATED
- HOME RUN TO PANEL
- WIRING IN CONDUIT
- 20A, 120VAC, SPLIT-WIRED, DUPLEX RECEPTACLE ASSEMBLY, NEMA 4X RATED.
- CIRCUIT BREAKER, SIZE AS INDICATED
- BYPASS PUMP CONTROL PANEL. 600V, 3PH, 2x20HP DUPLEX TRIPLEX PUMP CONTROLLER. NEMA 1 INTERIOR ENCLOSURE WITH HEATER. NEMA 4X STAINLESS STEEL EXTERIOR ENCLOSURE WITH VIEWING WINDOW.
- FLOAT SWITCH, SUPPLIED BY DIVISION 46.
- TRASH PUMP, "X" DENOTES PUMP IDENTIFIER, SUPPLIED BY DIVISION 46.

KEYNOTES:

- BYPASS SYSTEM POWER AND CONTROL CABLES TO BE TECK 90. EXTERIOR PORTION OF CABLE RUNS BETWEEN BUILDING AND BYPASS TANK TO BE DIRECT BURIED AT A DEPTH OF 100mm BELOW FINISHED GRADE. REFER TO DRAWING 26-2 FOR CABLING REQUIREMENTS.
- REFER TO DRAWING 46-2 FOR EXACT PUMP LOCATIONS.
- FLOAT SWITCH CABLES SUPPLIED WITH FLOAT SWITCH. FLOAT SWITCHES SUPPLIED BY DIVISION 46.
- REFER TO BYPASS CONTROL PANEL SHOP DRAWINGS FOR ALL CABLE TERMINATION DETAILS.
- PROVIDE STEEL SUPPORT STRUCTURE FOR PANEL BCP AND CONNECT TO PUMP SKID. PANEL HEIGHT TO BE 1200mm ABOVE BOTTOM OF PUMP SKID. PUMP SKID SUPPLIED BY DIVISION 46.
- EXTERIOR ENCLOSURE WINDOW KIT TO BE INSTALLED SUCH THAT ALARM BEACON OF BYPASS PUMP CONTROL PANEL IS VISIBLE THROUGH WINDOW.
- RECEPTACLE CABLING TO BE BURIED WITH AND FOLLOW TEMPORARY TRASH PUMPS DISCHARGE PIPING TO LIFT STATION BUILDING. REFER TO DRAWING 46-2 FOR ADDITIONAL INFORMATION REGARDING CABLE PATHWAY AND DISTANCES.

EXP Services Inc.  
T: +1 506 452 9000 | F: +1 506 459 3954  
1133 Regent Street, Suite 300  
Fredericton, NB, E3B 3Z2  
CANADA  
[www.exp.com](http://www.exp.com)



• BUILDINGS • EARTH & ENVIRONMENT • ENERGY •  
• INDUSTRIAL • INFRASTRUCTURE • SUSTAINABILITY •

CAUTION: DO NOT SCALE DRAWINGS.  
THIS REPRODUCTION MAY BE AT A SIZE DIFFERENT THAN ORIGINALLY DRAWN. EXP ASSUMES NO RESPONSIBILITY FOR INCORRECT SCALING. UNAUTHORIZED REPRODUCTION OR REUSE IS STRICTLY PROHIBITED. NOT PUBLISHED - ALL RIGHTS RESERVED. EXP EXPRESSLY DISCLAIMS RESPONSIBILITY ARISING FROM UNAUTHORIZED USE OF THESE DRAWINGS AND NOTES. AUTHORIZATION MUST BE IN WRITING.

© EXP, 2020

No.	Issue	Date
A	ISSUED FOR REVIEW	2021.AUG.13
B	ISSUED FOR TENDER	2021.AUG.30
C	AS BUILT	2023.JAN.31

GENERAL NOTE:

- ITEMS IN GREY ARE EXITING OR SUPPLIED BY OTHERS.

SUBSCRIPTS:

4X NEMA 4X RATED

AS-BUILT  
DRAWING

AS-BUILT DRAWING INFORMATION PROVIDED BY  
NUNAVUT EXCAVATING LTD. TO EXP SERVICES INC.  
NO FIELD VERIFICATION WAS EXECUTED BY EXP.


No.	Revision	Date
-----	----------	------

AS-BUILT

Professional Seal(s)	

Drawn By: MRB

Dwg Standards Ckd By:

Designed By: PGH

Design Checked By:

Scale: 1:50

Project Title

LIFT STATION #1 BYPASS

Dwg. Title

TEMPORARY LIFT STATION  
ELECTRICAL SITE PLAN

Project No. FRN-21005203-A0

Dwg. No. Rev. No.

26-1

C



Dwg. Title

# TEMPORARY LIFT STATION ELECTRICAL DETAILS

Project No.

FRN-21005203-A0

Dwg. No.

**26-2**

Rev. No.

C