



<b>Project:</b>	LG Dam Safety Improvements	<b>RFT No.:</b>	2021-RFT-012
<b>Addendum No.:</b>	1	<b>No. of Pages:</b>	2
<b>Doc. No.</b>	P7201-313612880-35(1.0)	<b>Date:</b>	June 28, 2021

The following change(s) in the Tender Documents are effective immediately.  
 This Addendum forms part of the Contract Documents.

ITEM	DESCRIPTION
1.1	<p>Bidder Question</p> <p>Question: What are the general historic water levels in July and August of Lake Geraldine and downstream of the dam? Would the contractor likely be working in water on the downstream side of the dam to complete items 3 &amp; 4 under schedule 'A' of the unit price table?</p> <p>Answer: Water levels for station 10UH013 can be found at:  <a href="https://wateroffice.ec.gc.ca/report/real_time_e.html?stn=10UH013">https://wateroffice.ec.gc.ca/report/real_time_e.html?stn=10UH013</a>            There is no water present on the downstream side of the Dam.</p>
1.2	<p>Bidder Question</p> <p>Question: Please clarify if the granular fill is Gran 'A' or Gran 'B', detailed under schedule 'A' item 1 of the unit price table.</p> <p>Answer: Granular A.</p>
1.3	<p>Bidder Question</p> <p>Question: On drawing C2.0 the dashed lines for the temporary guardrail as well as the dashed lines for the expansion joints are very similar. Could you clarify which lines are for the expansion joints?</p> <p>Answer: See attached drawing C2.0 Issued for Addendum No.1 dated June 28, 2021.</p>
1.4	<p><b>Clarification:</b> As noted on drawing C2.0, the guardrail was not previously abandoned by a contractor but rather requested to be left in place by the City for safety purposes. This material belongs to Kudlik Construction Ltd. and must be returned to Kudlik in its entirety if removed.</p>

Project Name: LG Dam Safety Improvements 2021-RFT-012


Addendum No.: 1

Colliers Project Leaders Inc.


Date: June 28, 2021

Distribution:

All Bidders  
File

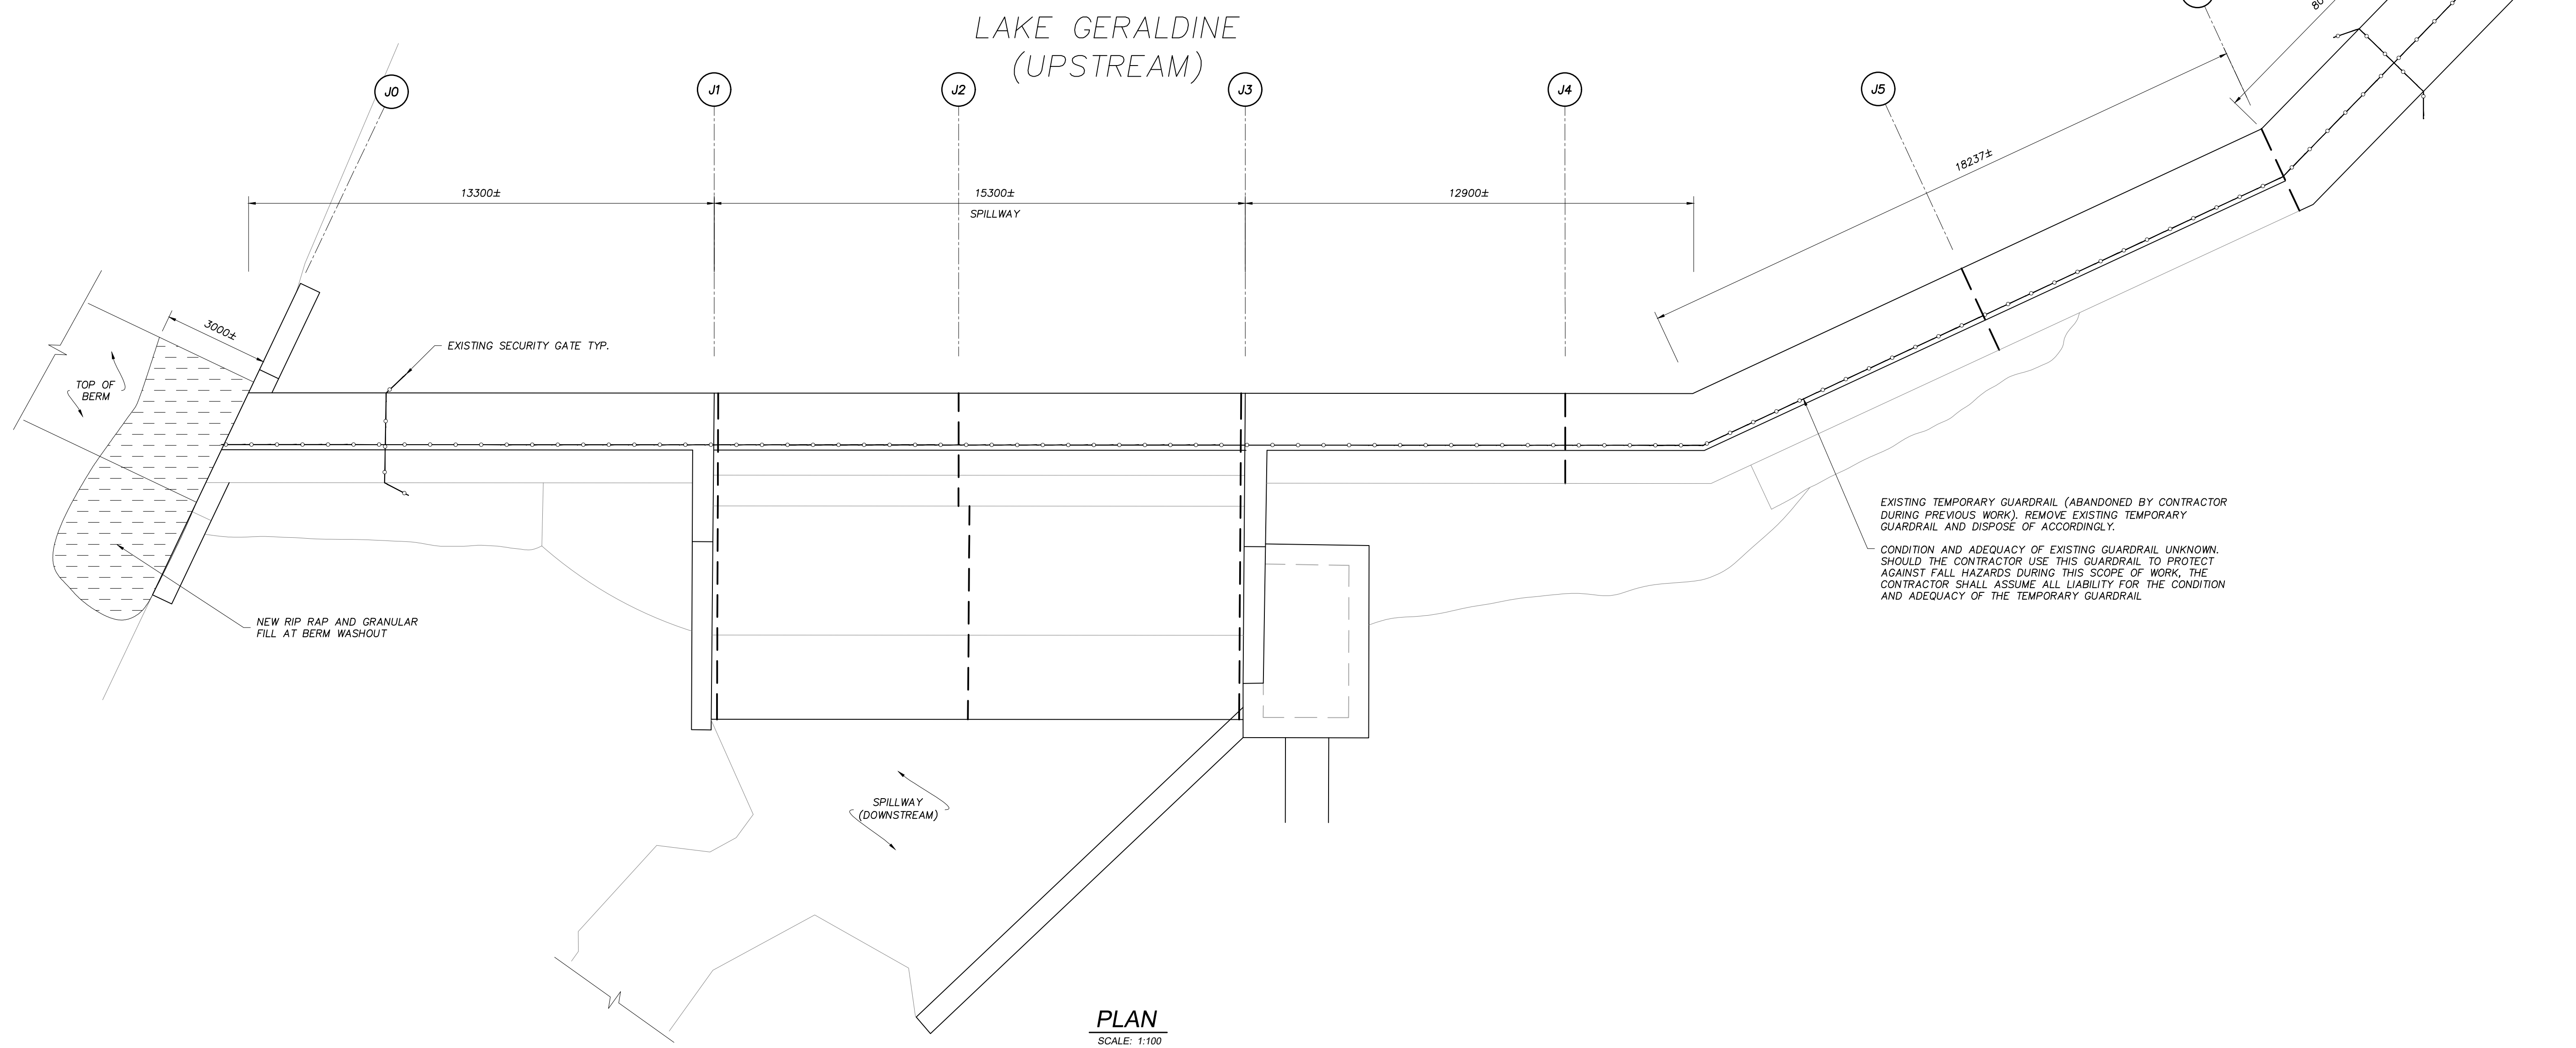

**PLAN**  
SCALE: 1:100

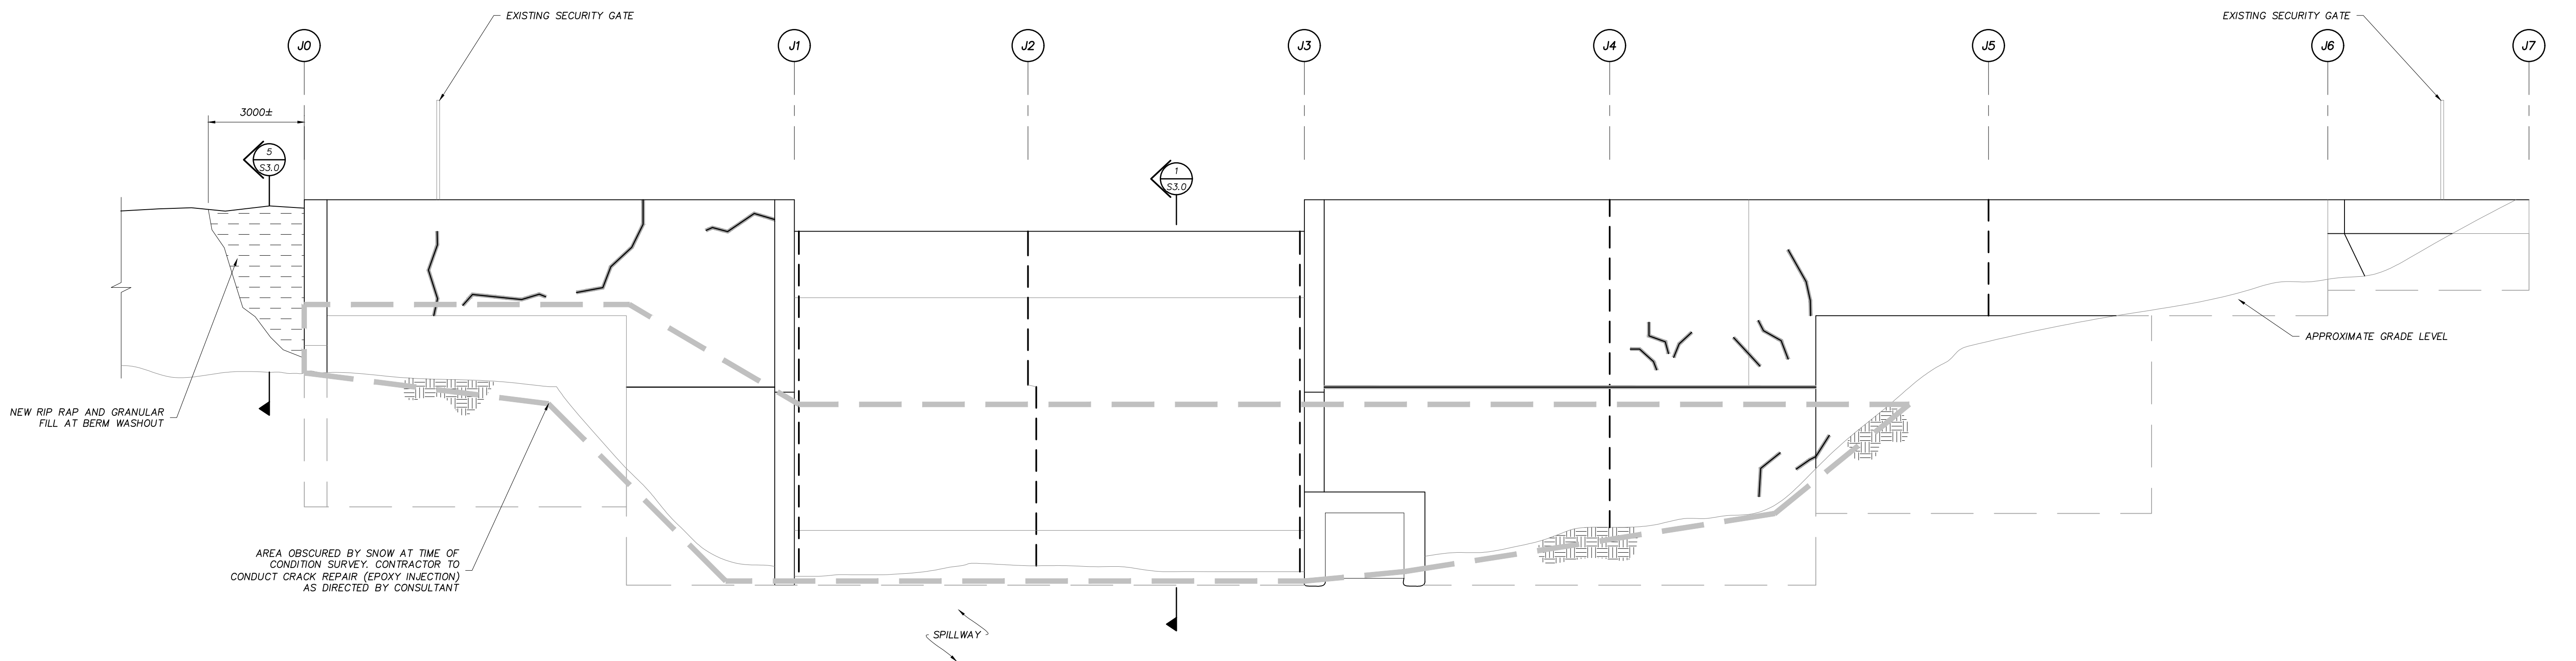

**ELEVATION - DOWNSTREAM**  
SCALE: 1:100

NO.	REVISION	DATE
1	ISSUED FOR 66% REVIEW	MAY 6, 2021
2	ISSUED FOR 99% REVIEW	MAY 31, 2021
3	ISSUED FOR TENDER	JUNE 9, 2021
4	ISSUED FOR ADDENDUM NO. 1	JUNE 28, 2021
5		
6		
7		

**NOTES:**  
 CONTRACTOR SHALL CHECK AND VERIFY ALL DIMENSIONS AND BE RESPONSIBLE FOR REPORTING ALL DISCREPANCIES TO OWNER AND/OR CONSULTANT PRIOR TO TENDER CLOSING.  
 LATEST APPROVED DRAWINGS ONLY TO BE USED FOR CONSTRUCTION.  
 PRINTS ARE NOT TO BE SCALED.

**LEGEND**

	REPLACE ALL EXPANSION JOINTS
	AREA OF RIP RAP AND GRANULAR FILL
	CRACK REPAIR (EPOXY INJECTION)
	EXISTING GUARDRAIL OR SECURITY GATE

SEE SHEET S3.0 FOR REPAIR DETAILS

**CONCENTRIC**  
CLIENT-CENTRIC. CHALLENGE DRIVER.

<b>LONDON</b> Toll Free 1-866-919-4531	<b>OTTAWA</b> Toll Free 1-866-919-4530
<b>IQALUIT</b> Toll Free 1-866-919-4531	<b>SASKATOON</b> Toll Free 1-866-919-8899
<b>WINNIPEG</b> Toll Free 1-866-919-4531	<b>TORONTO</b> Tel. 1-647-351-0095
<b>COQUITLAM</b> Toll Free 1-866-919-4531	

CLIENT NAME:  
CITY OF IQALUIT

PROJECT ADDRESS:  
IQALUIT, NUNAVUT

PROJECT NAME:  
LAKE GERALDINE DAM  
2021 REHABILITATION PROGRAM

DRAWING TITLE:  
CONCRETE DAM PLAN & ELEVATION

DESIGN: KPT	SCALE: AS SHOWN
DRAWN: NCM	DATE: JUNE 2021
APPVD: STP	FILE No: 21-9162

SHEET No.  
**C2.0**